



FIRE ELECTRICAL KEY	
SYM.	DESCRIPTION
⊙	SMOKE DETECTOR
⊖	FIRE ALARM
Ⓐ	FIRE ALARM W/ STROBE
Ⓜ	HEAT DETECTOR
⊕	FIRE EXTINGUISHER
Ⓛ	LIGHTED EXIT SIGN
Ⓛ	EMERGENCY LIGHTS
Ⓜ	FIRE ALARM FULL

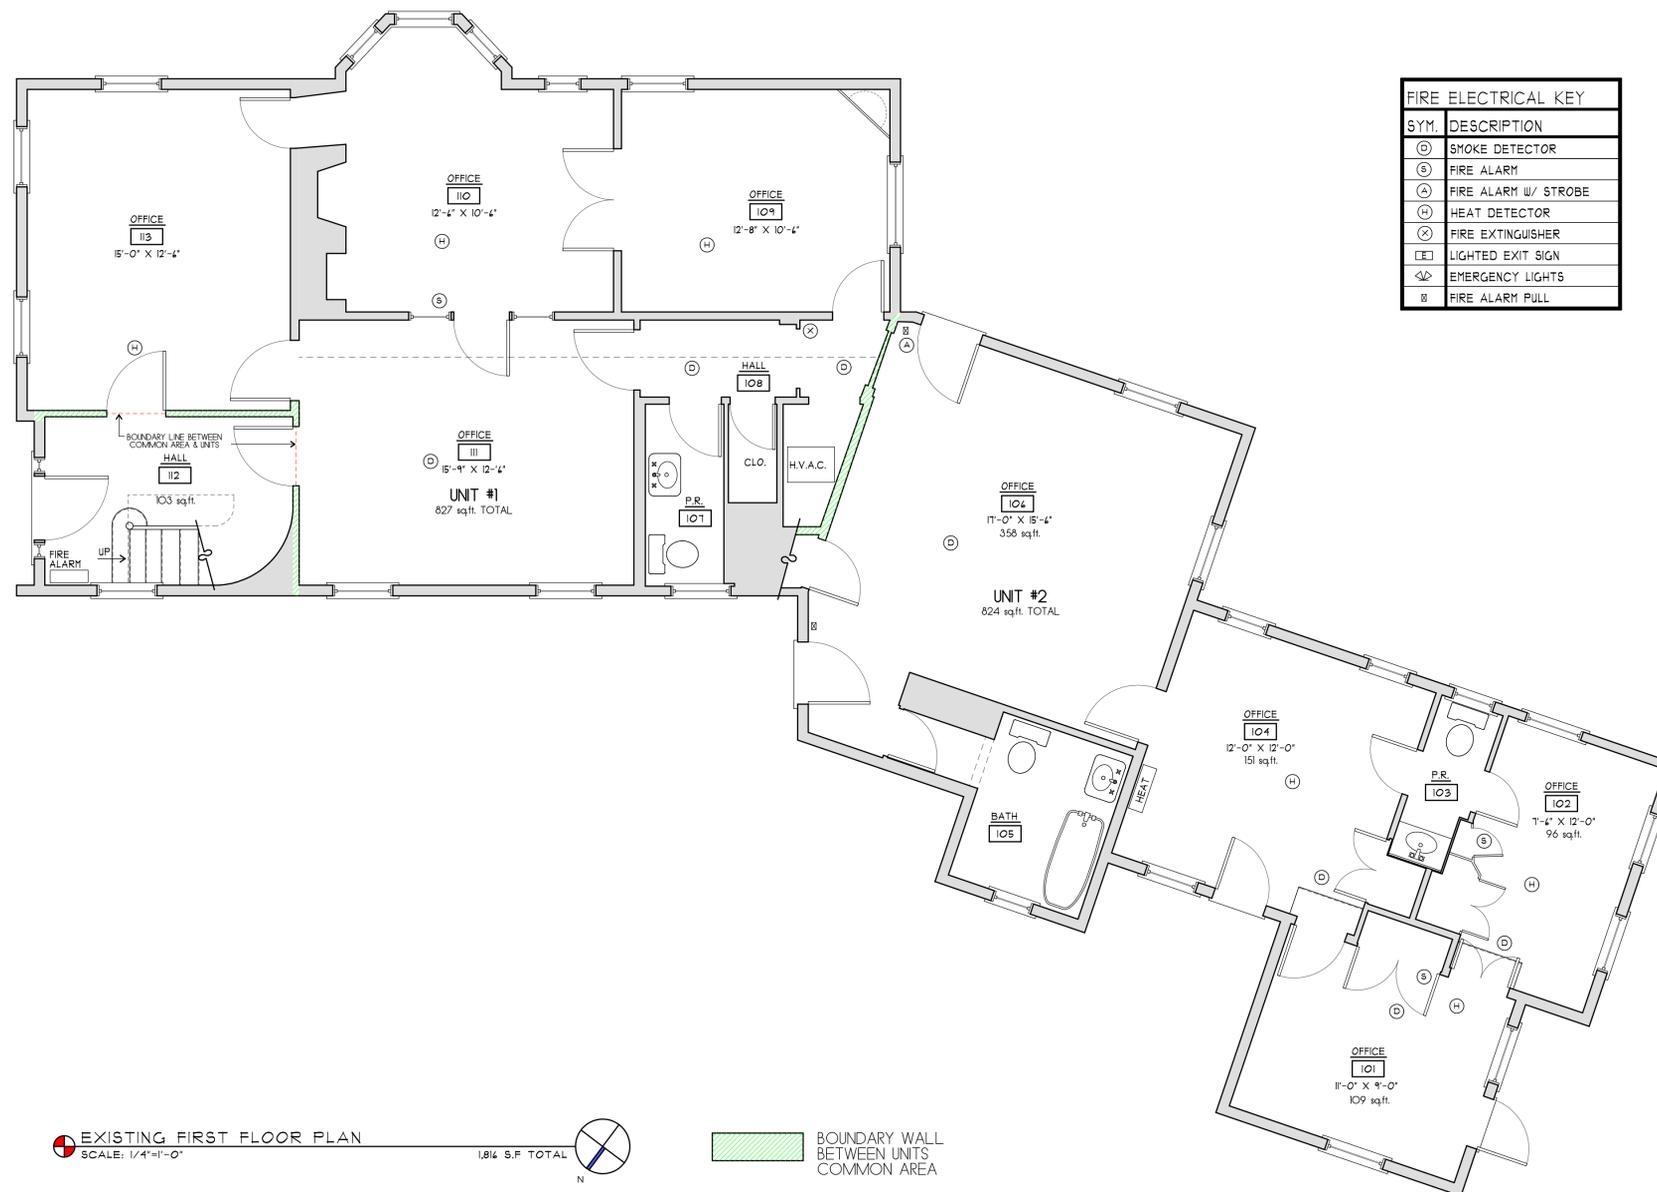


REVISIONS:
1/30/2017: AS-BUILT MEASURING
2/14/2017: AS-BUILT PLANS

FIRST FLOOR FRONT

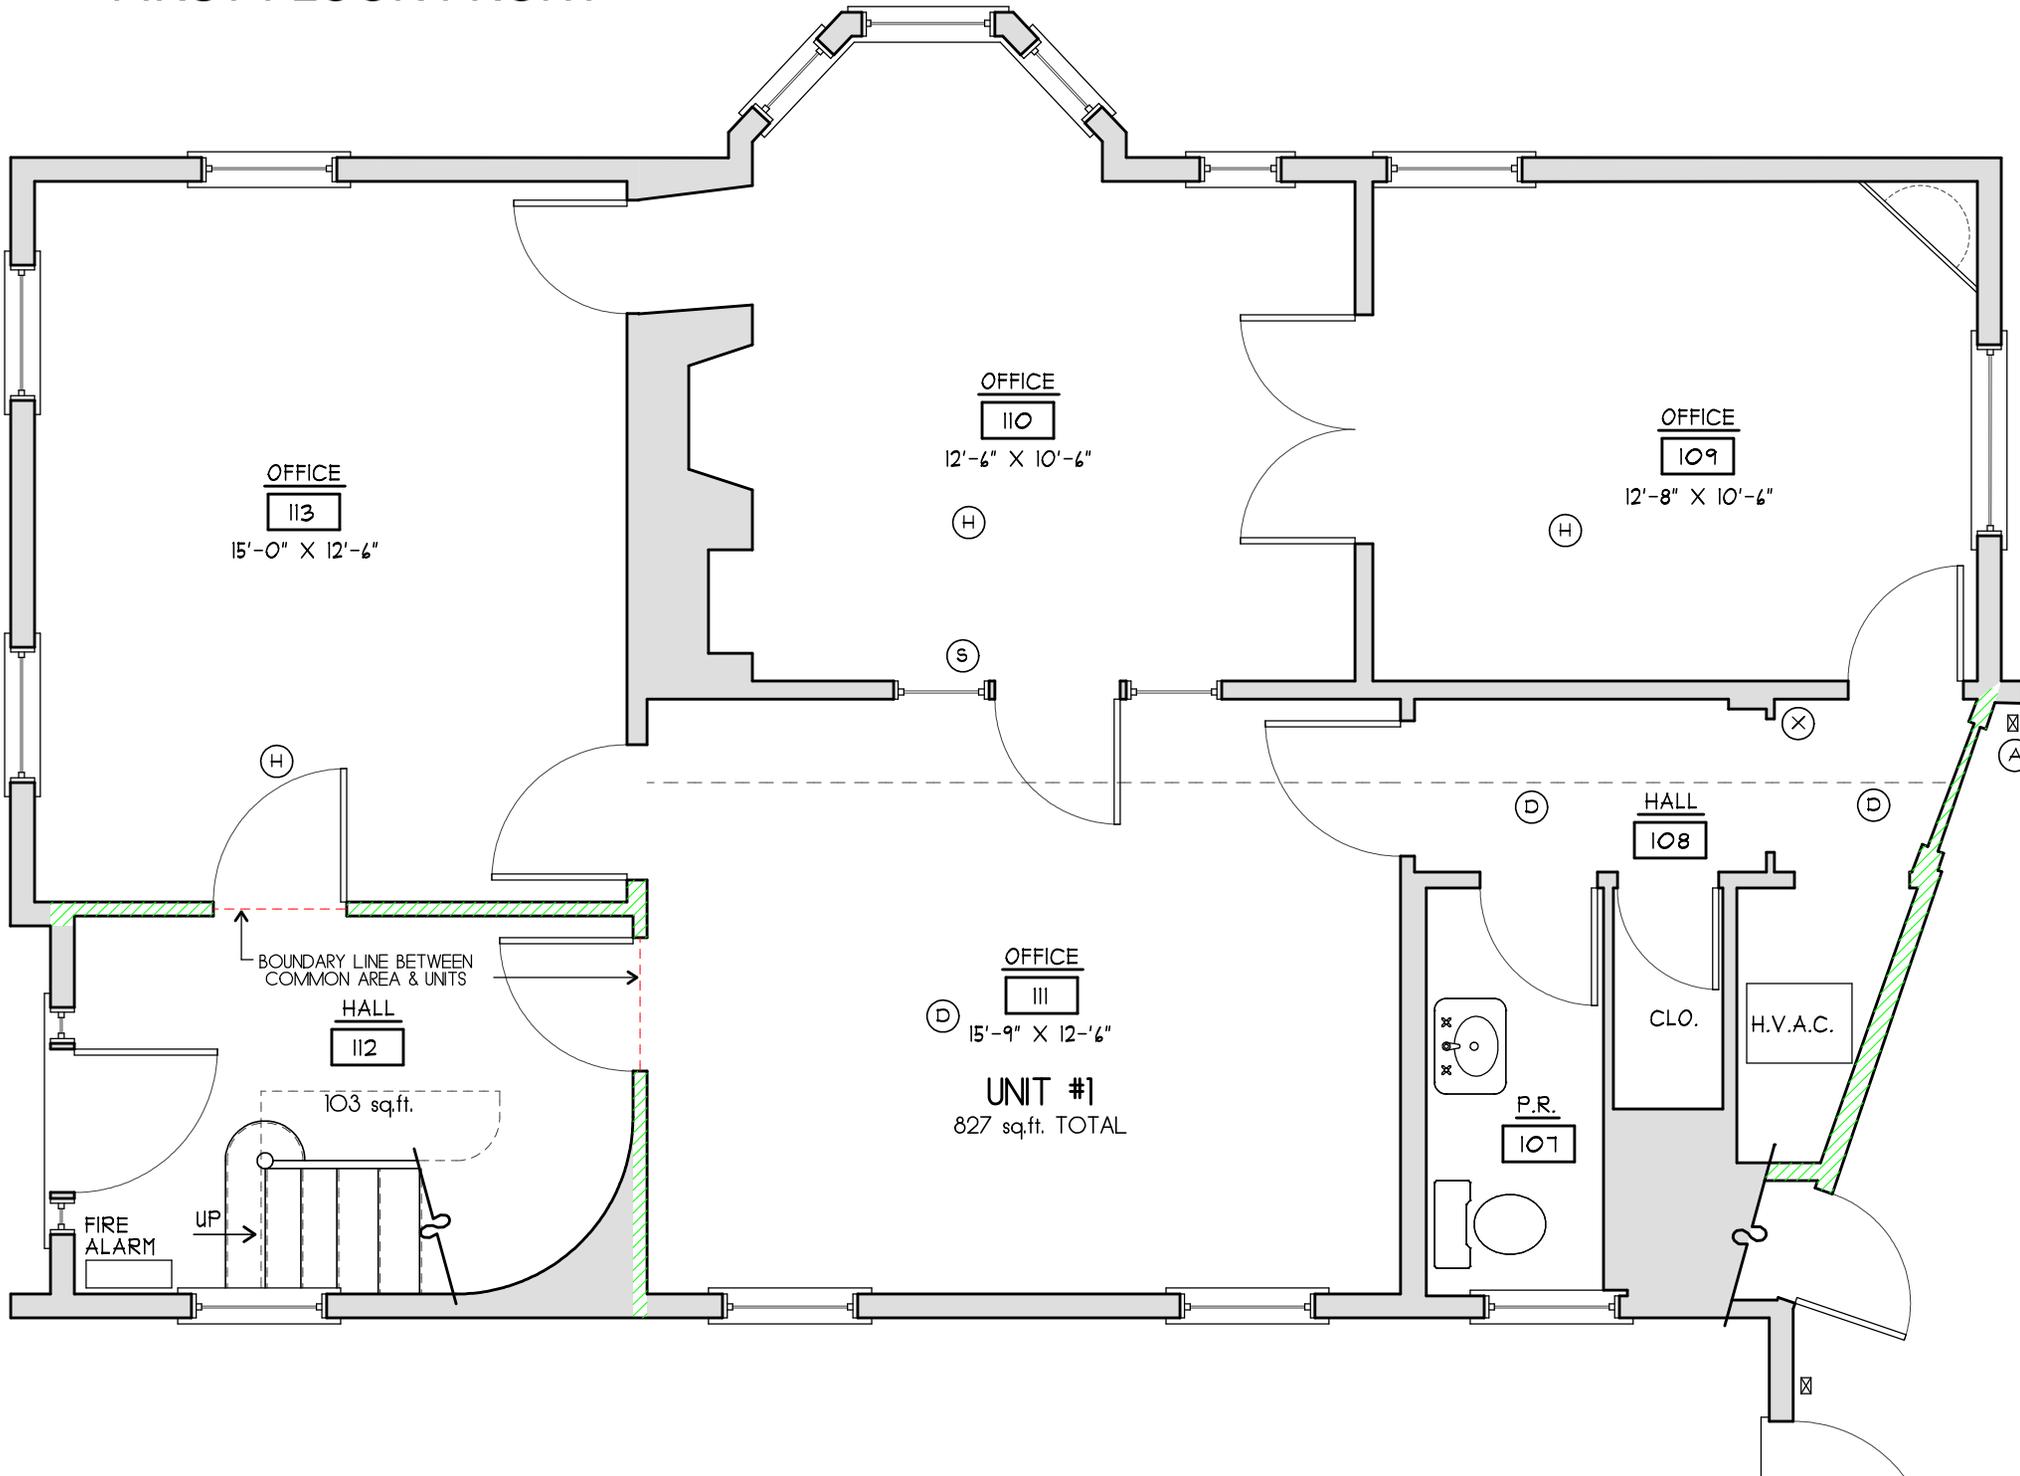

FIRST FLOOR REAR

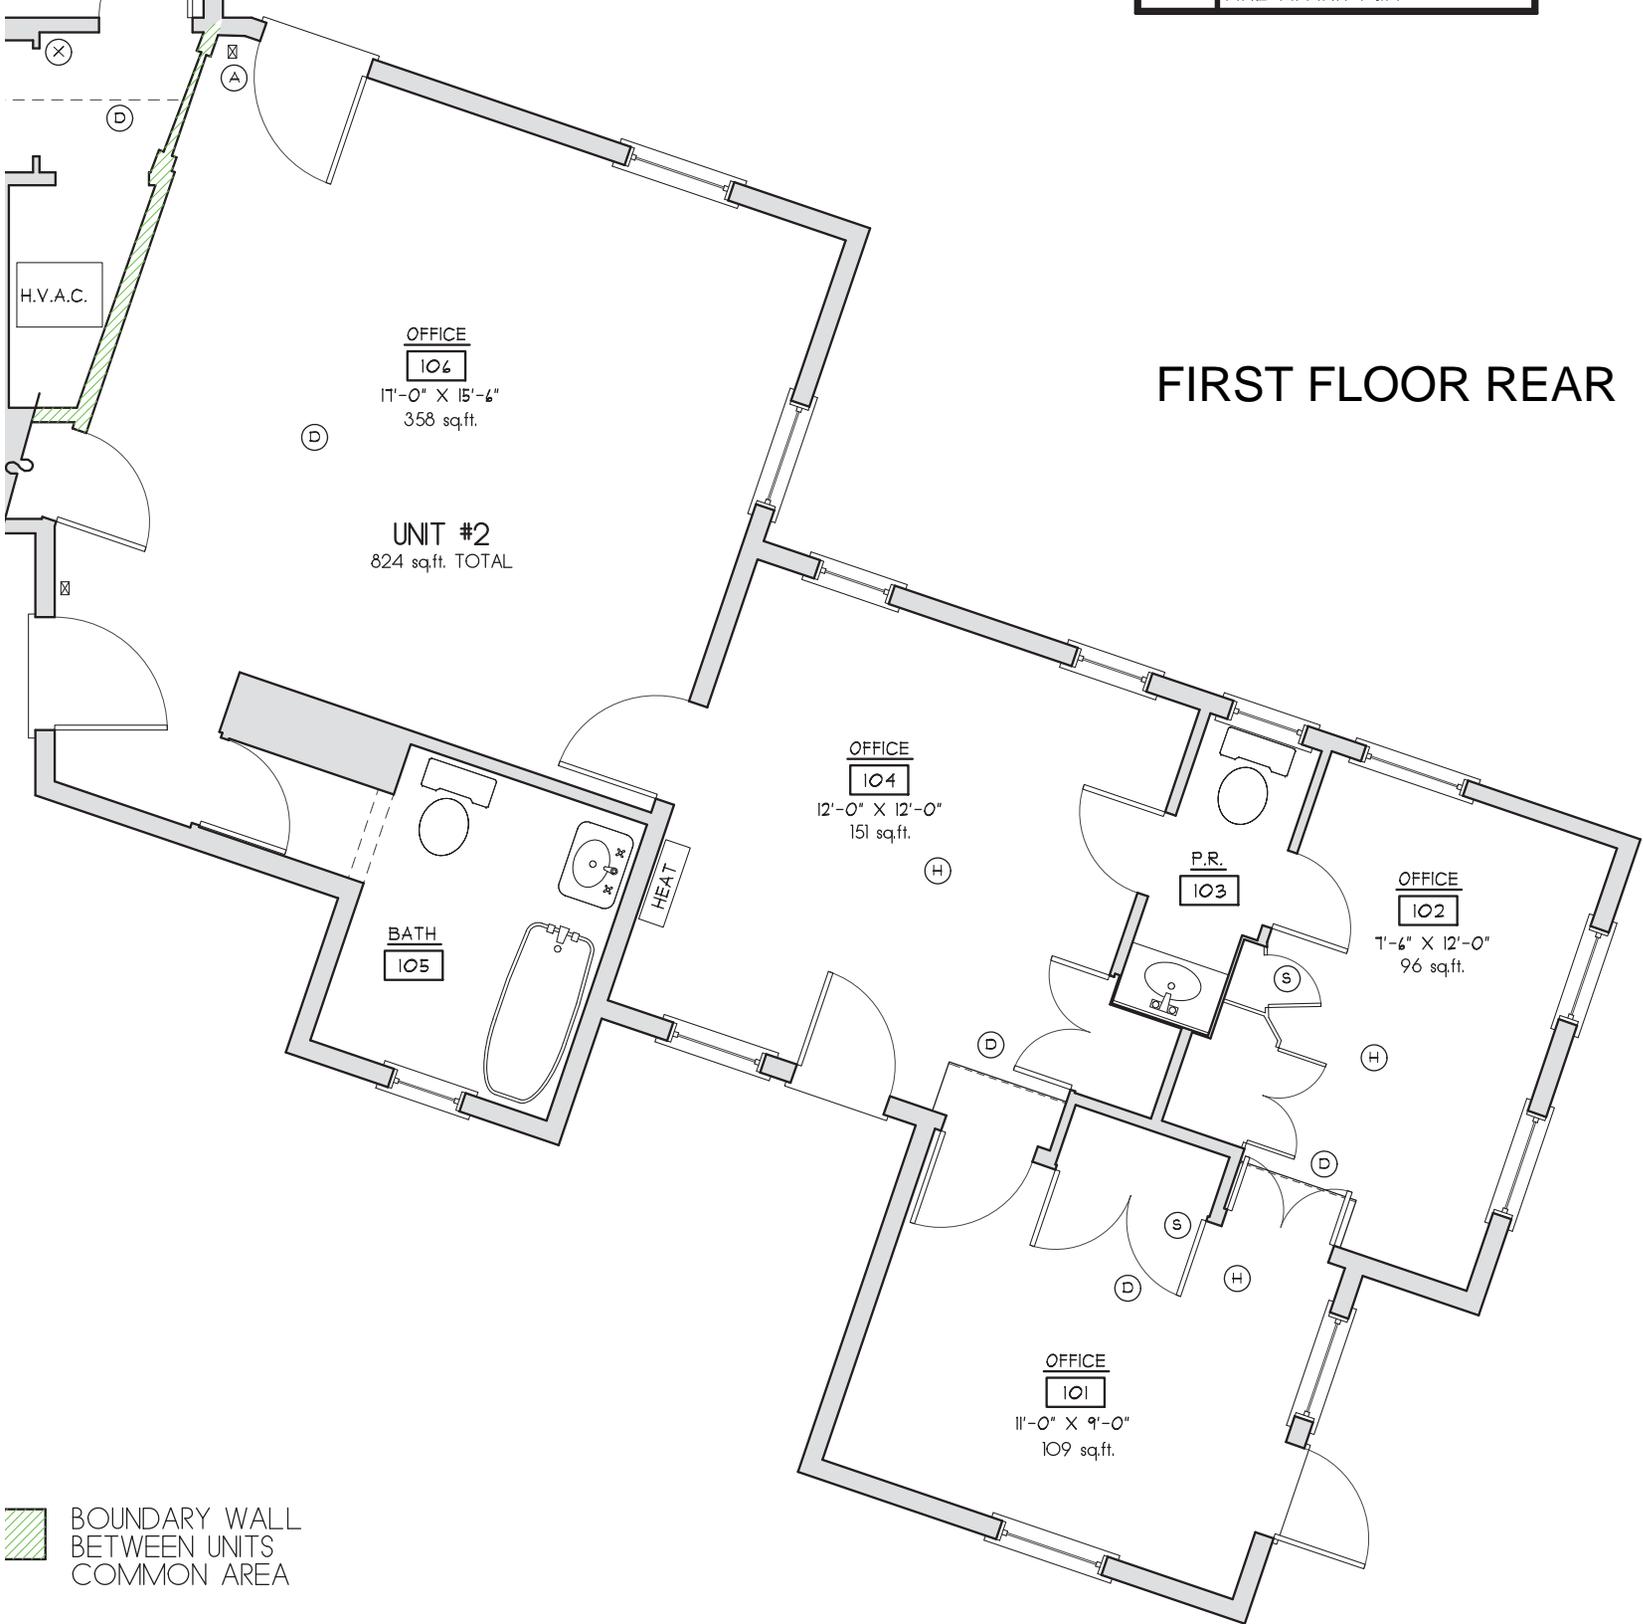

OFFICE
106
17'-0" X 15'-6"
358 sq.ft.

UNIT #2
824 sq.ft. TOTAL

OFFICE
104
12'-0" X 12'-0"
151 sq.ft.


BATH
105

P.R.
103

OFFICE
102
7'-6" X 12'-0"
96 sq.ft.


OFFICE
101
11'-0" X 9'-0"
109 sq.ft.

BOUNDARY WALL
BETWEEN UNITS
COMMON AREA

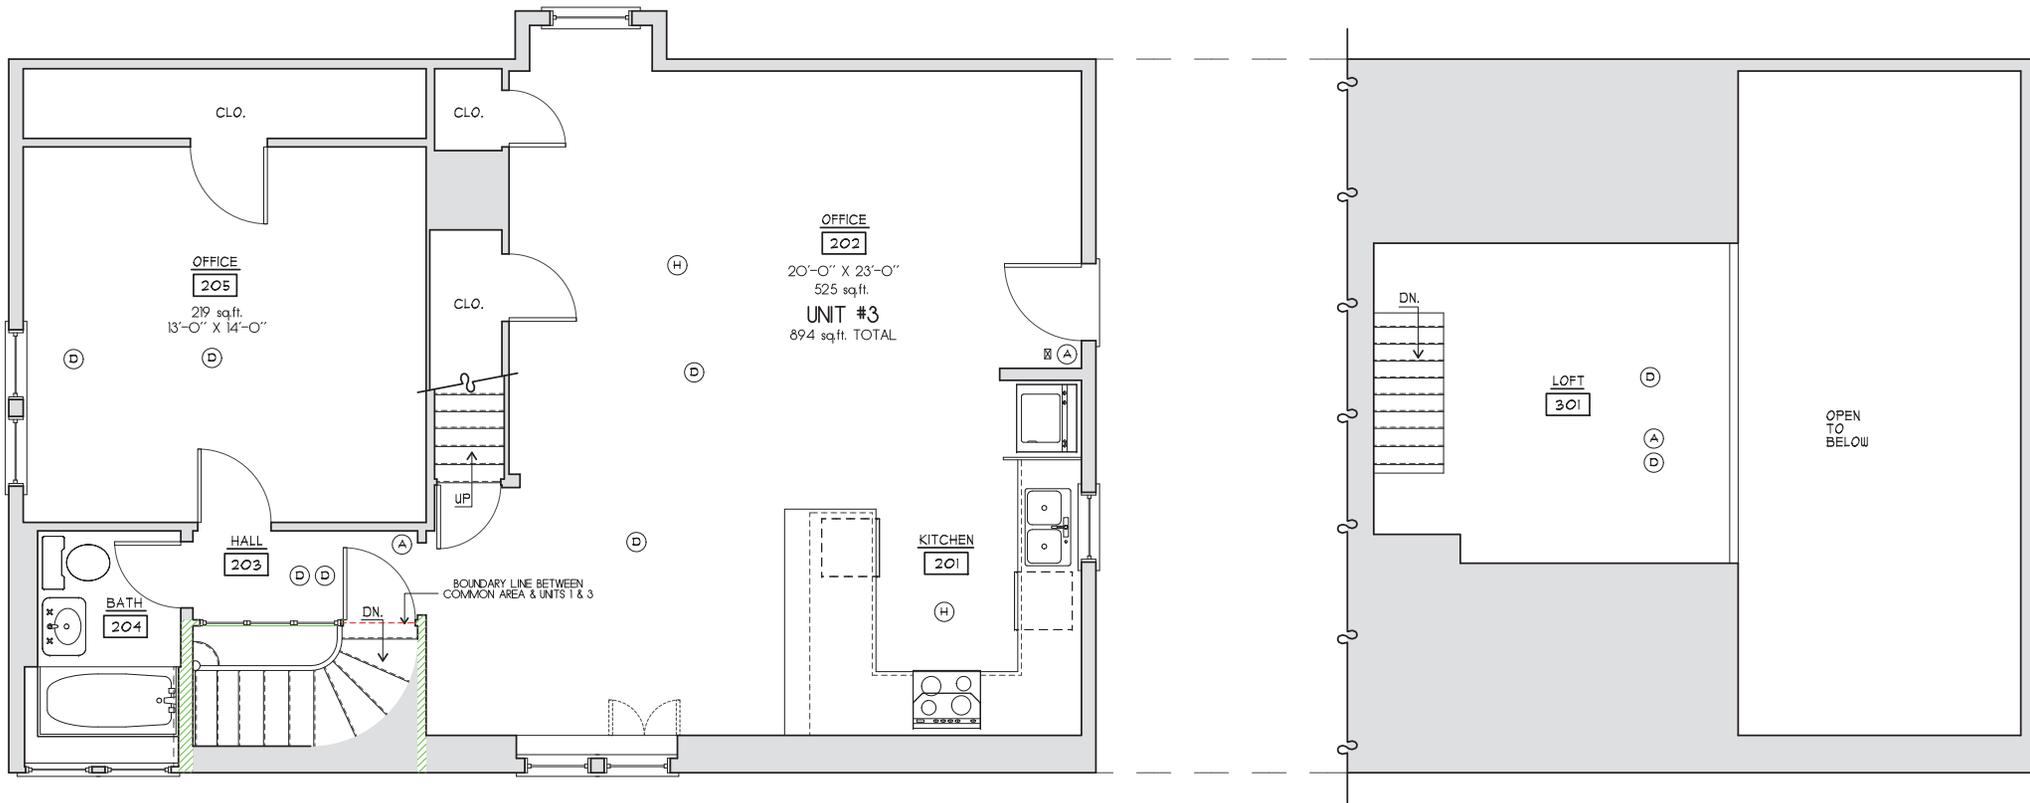


EXISTING SECOND FLOOR & LOFT PLAN
 SCALE: 1/4"=1'-0"


 BOUNDARY WALL
 BETWEEN UNIT 1, 3,
 & COMMON AREA

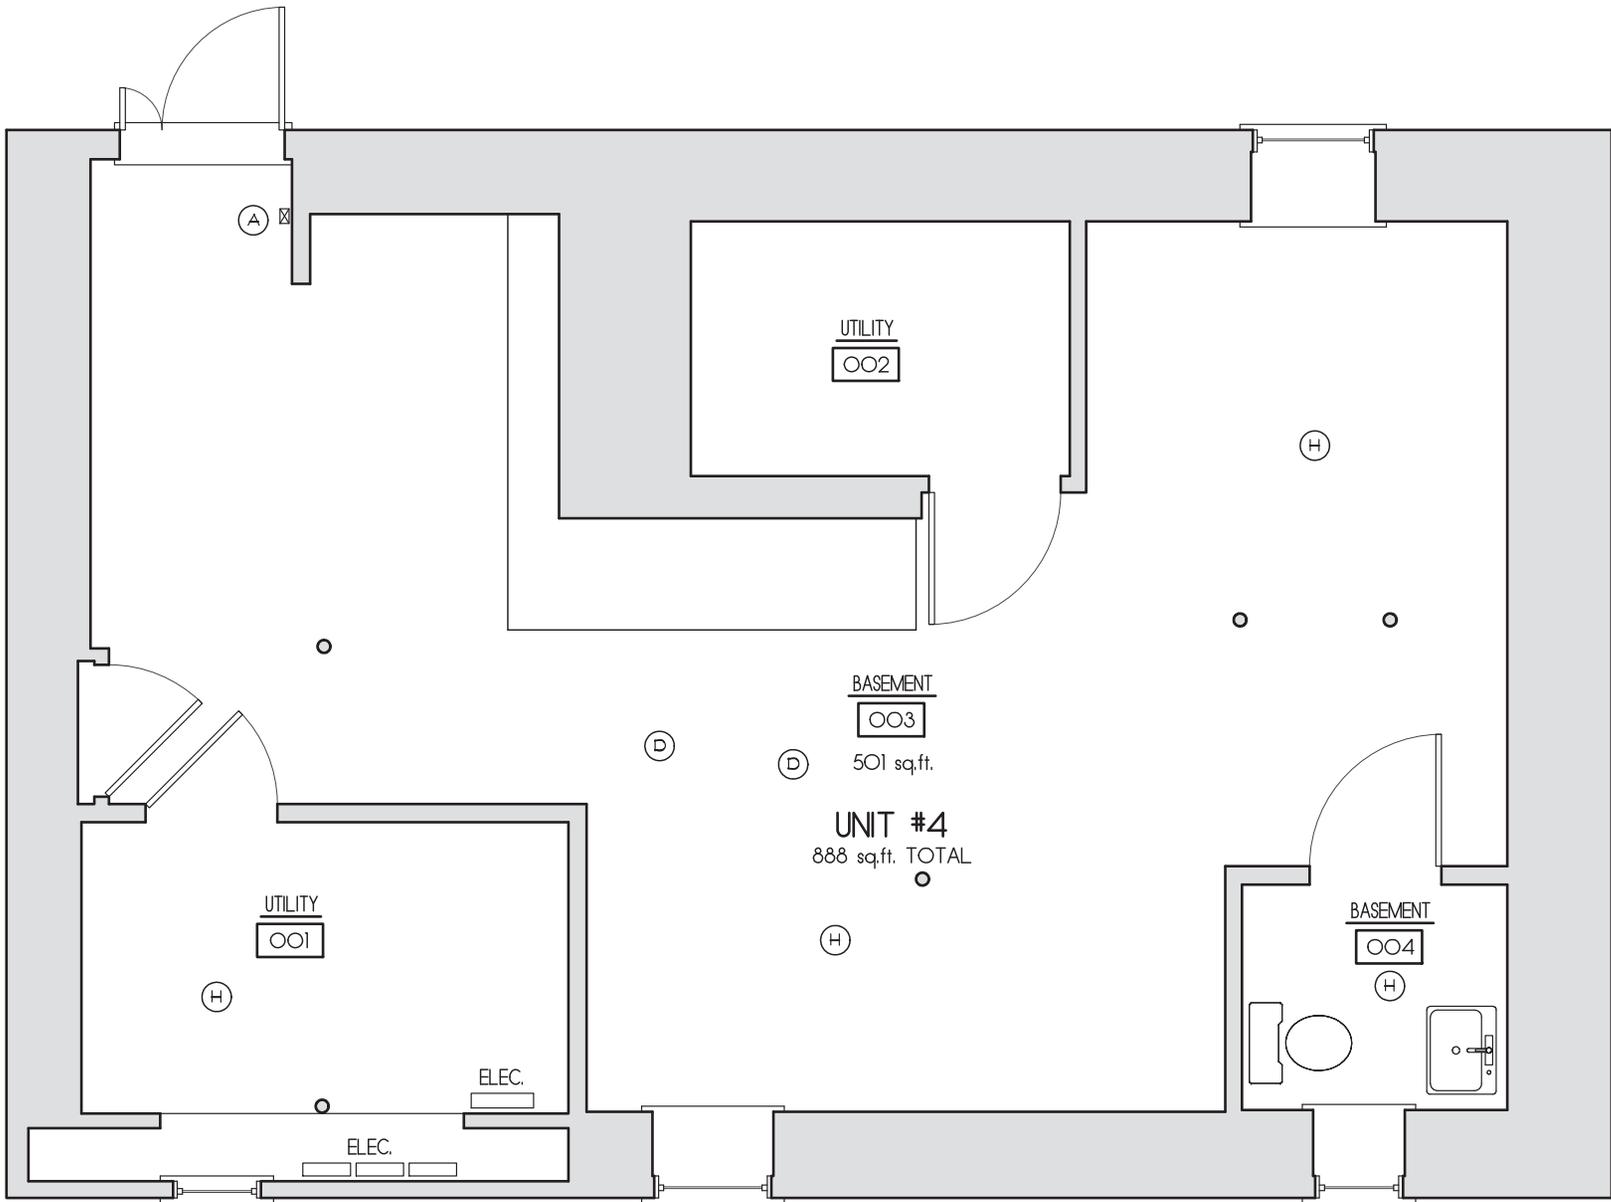

 EXISTING BASEMENT PLAN

SCALE: 1/4"=1'-0"