


THE POGORELC RESIDENCE

1 CHESTER ST.


NANTUCKET, MA 02554

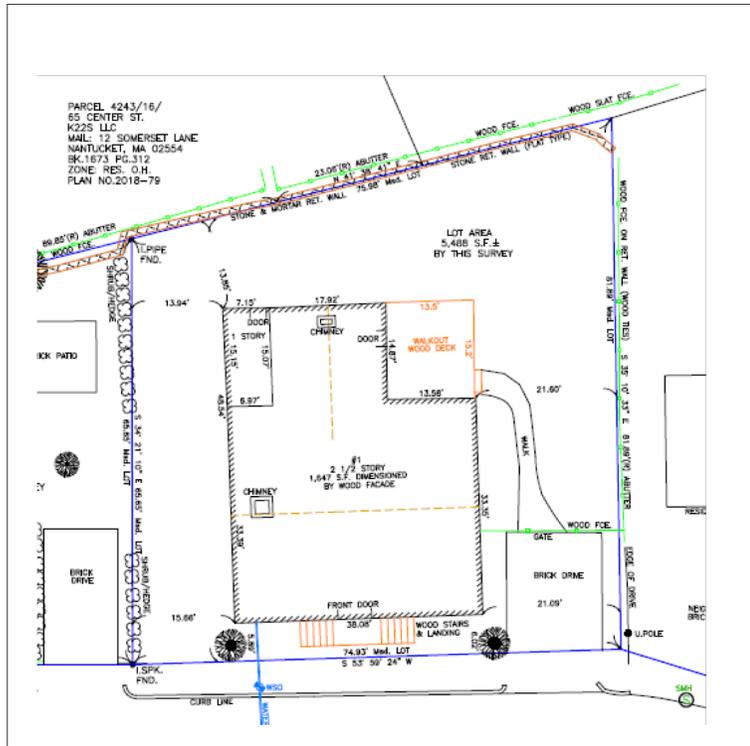


EXISTING CONDITIONS



NOT FOR CONSTRUCTION

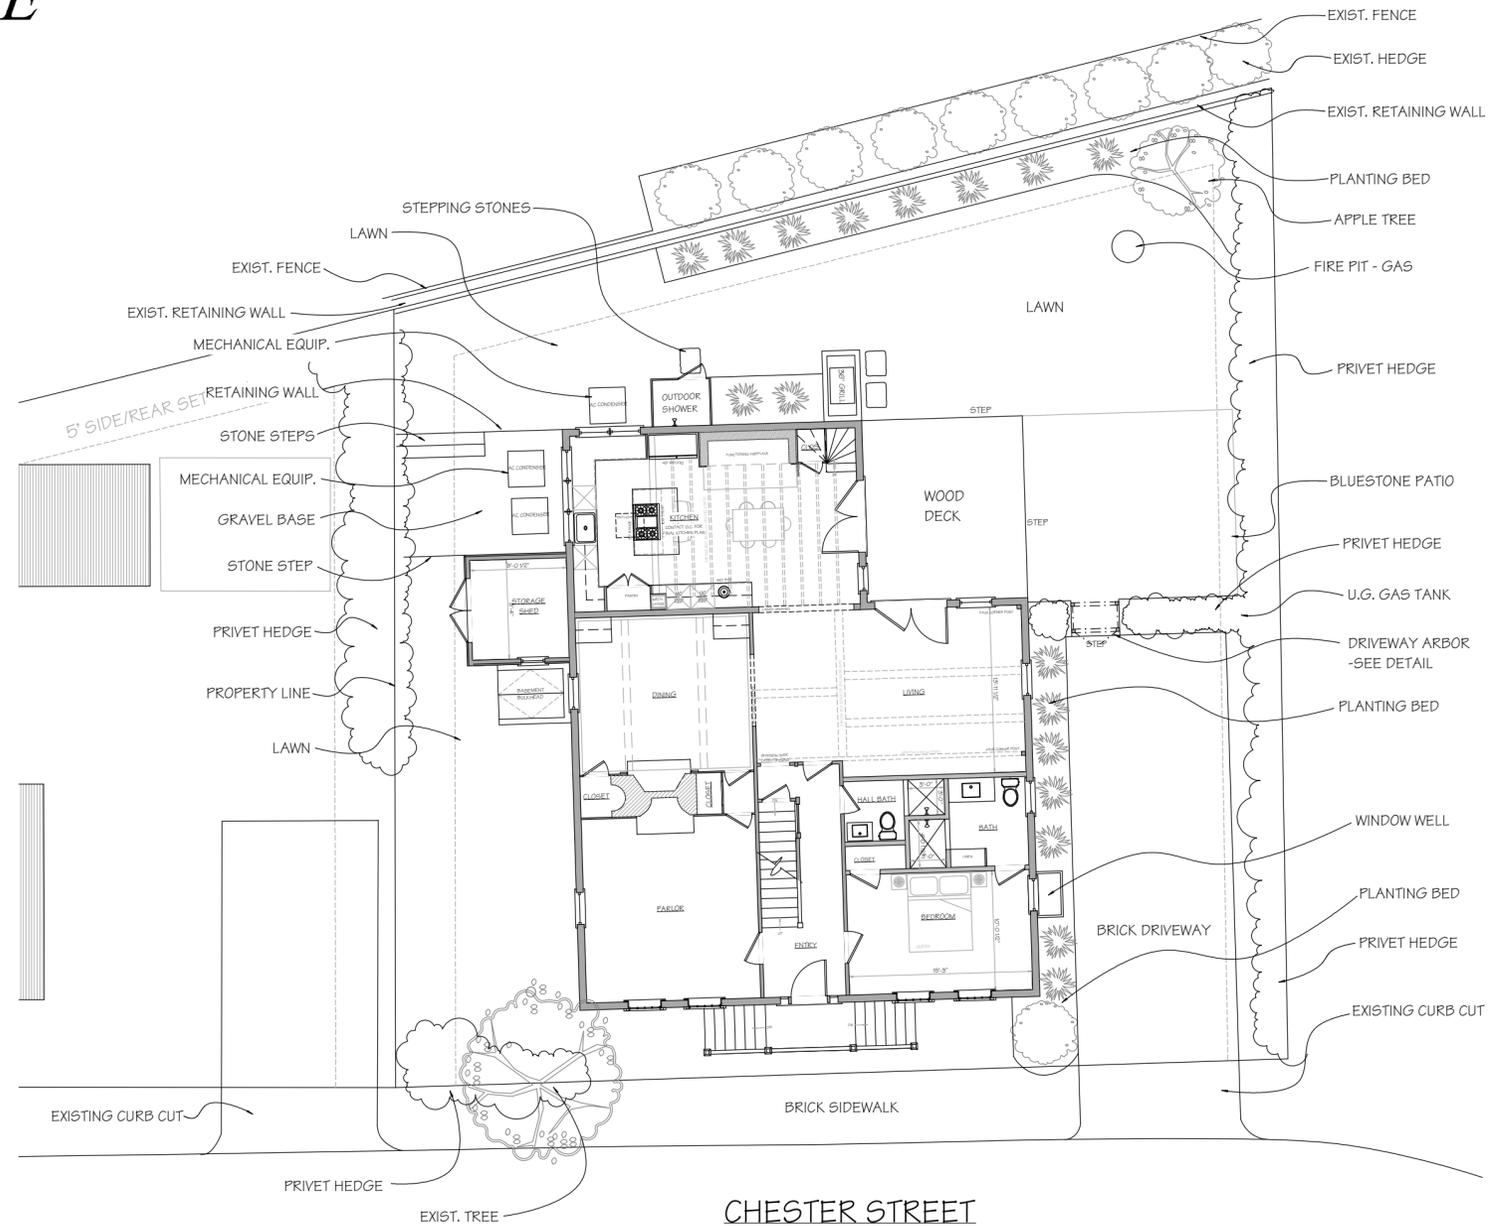

SITE PLAN
SCALE: 1" = 10'

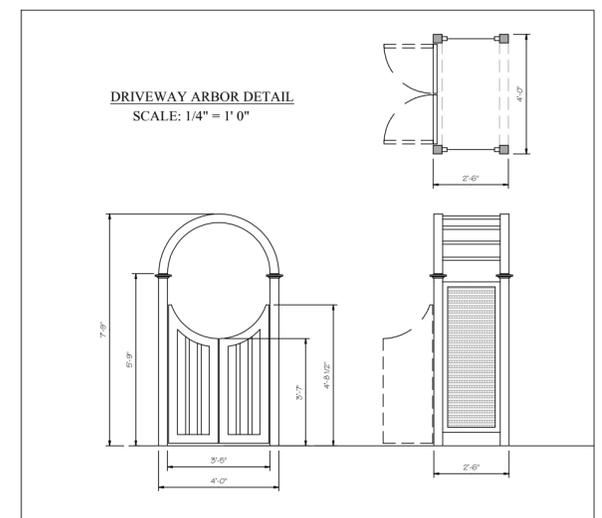

Design and drawings are the property of Normand Residential Design, Inc. and may not be used without their written consent. All rights reserved. © 2023

COVER SHEET
DATE: 04/11/2023
SCALE: AS NOTED

M/P: 42.4.3 / 18



FIRST FLOOR PLAN

NOT FOR CONSTRUCTION

THE POGORELC RESIDENCE
 1 CHESTER ST
 NANTUCKET, MA

FIRST FLOOR PLAN
 DATE: 04/11/2023
 SCALE: 1/4" = 1'-0"

M/P: 42.4.3 / 18

Design and drawings herein are property of Benjamin Normand Residential Design, Inc. and may not be used without their written consent. Copyright laws can and will be enforced.

BENJAMIN
NORMAND RESIDENTIAL
 DESIGN, INC
 15 COMMERCIAL WHARF - NANTUCKET, MA 02554
 (508) 228-2044 NORMANDRESIDENTIAL.COM



SECOND FLOOR PLAN

NOT FOR CONSTRUCTION



SECOND FLOOR PLAN


AS-BUILT

Design and drawings herein are property of Benjamin Normand Residential Design, Inc. All rights reserved. No part of this document may be reproduced, stored in a retrieval system, or transmitted in any form or by any means, electronic, mechanical, photocopying, recording, or by any information storage and retrieval system, without the prior written permission of Benjamin Normand Residential Design, Inc.

SECOND FLOOR PLAN
 DATE: 04/11/2023
 SCALE: 1/4" = 1' 0"

M/P: 42.4.3 / 18


THE POGORELC RESIDENCE
 1 CHESTER ST
 NANTUCKET, MA

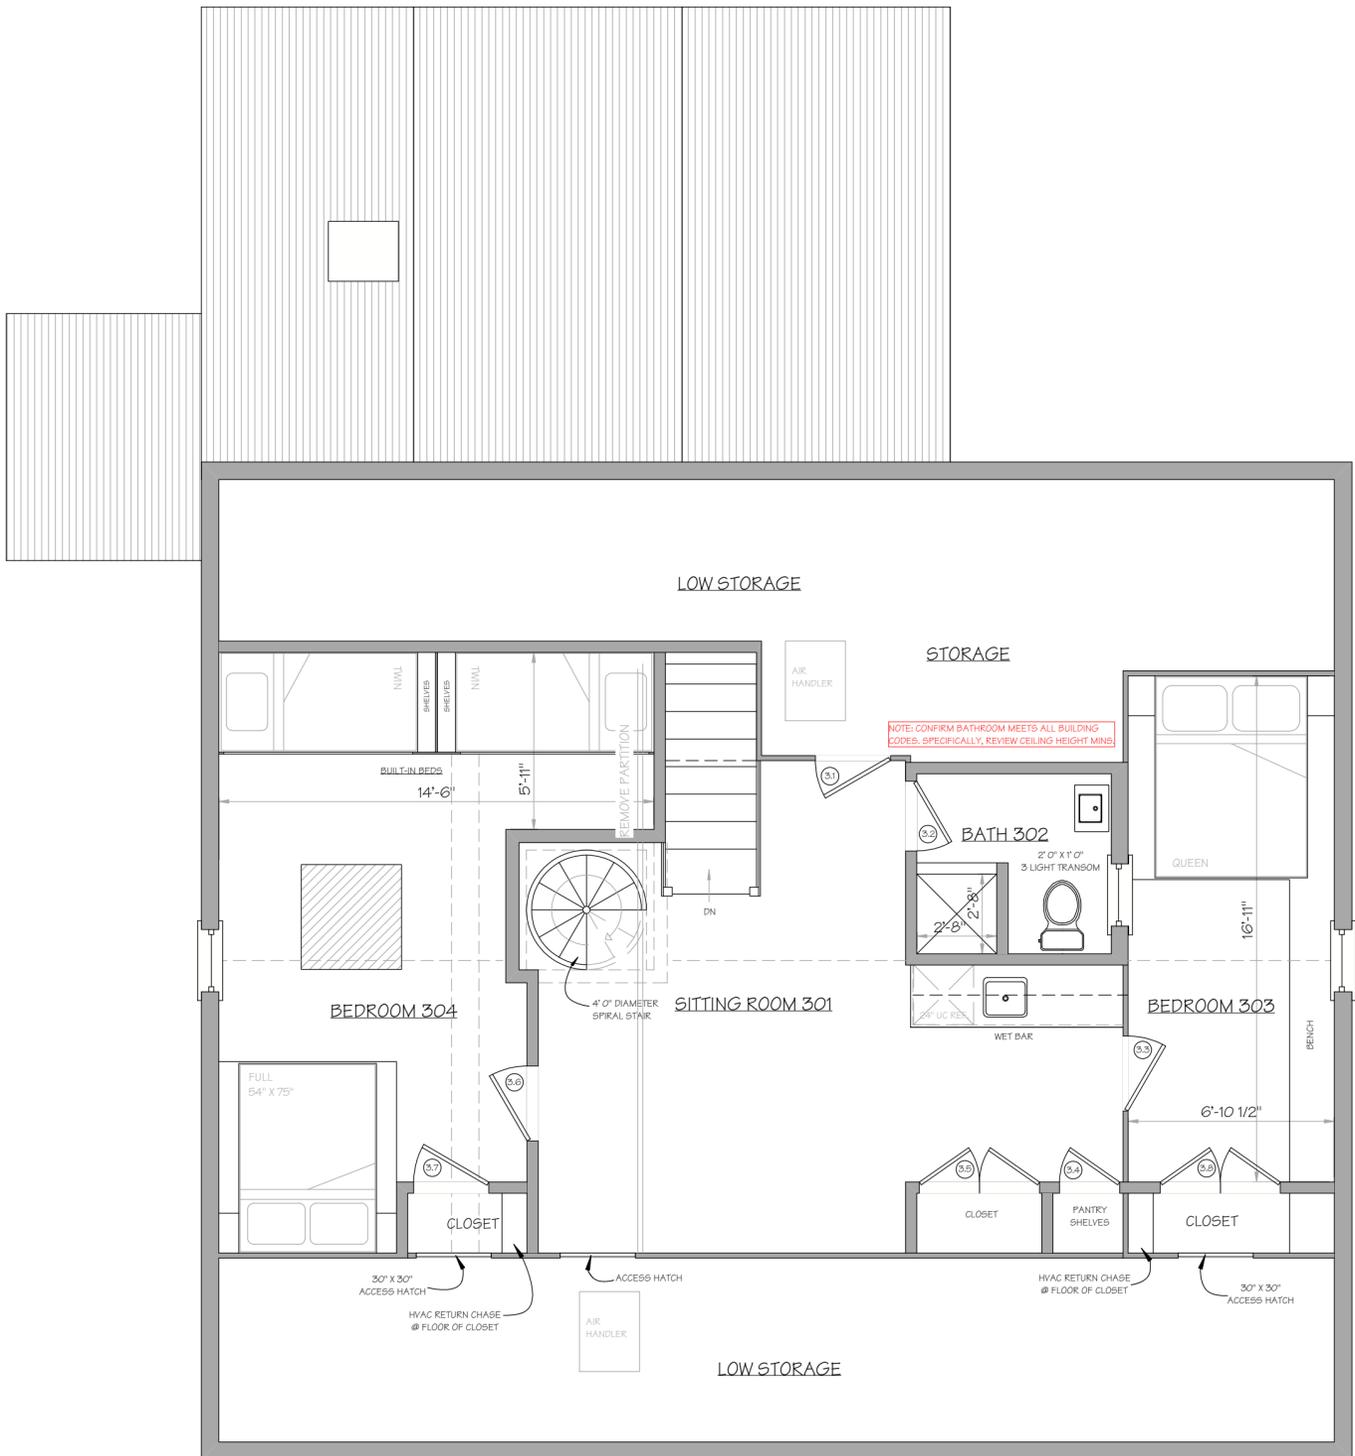

THIRD FLOOR PLAN


- GENERAL NOTES:
- THIRD FLOOR CATHEDRAL THROUGHOUT
 - ACCESS DOORS IN EACH BEDROOM INTO STORAGE SPACES
 - SHIPLAP WALLS TO BE PAINTED WHITE
 - CHIMNEY TO BE PARGED AND PAINTED WHITE

NOT FOR CONSTRUCTION

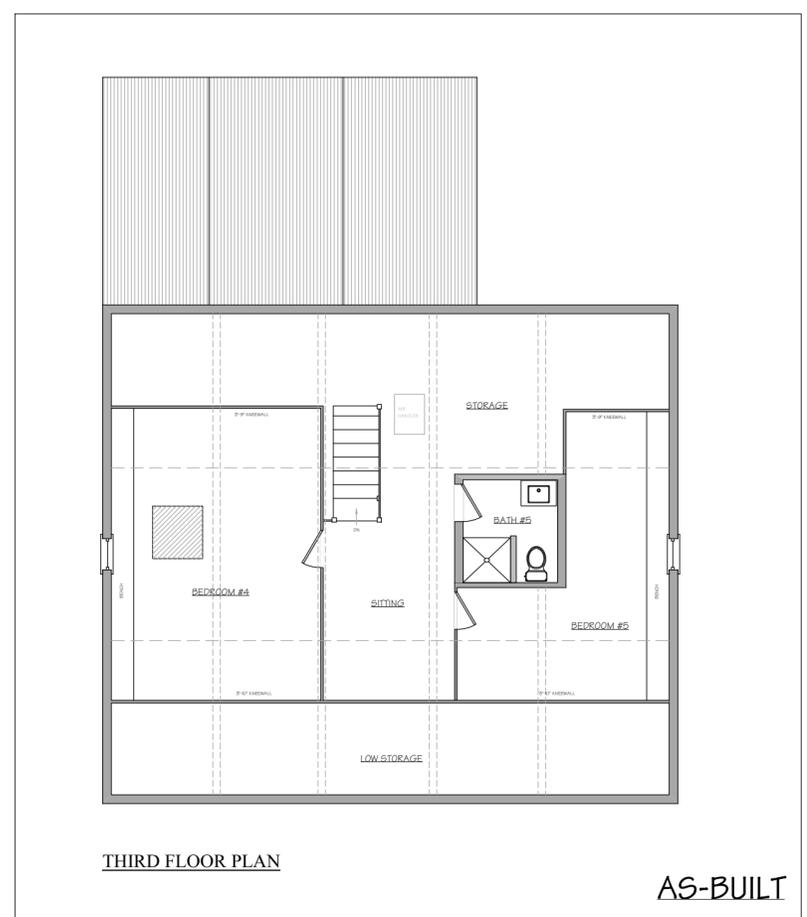


THIRD FLOOR PLAN

AS-BUILT

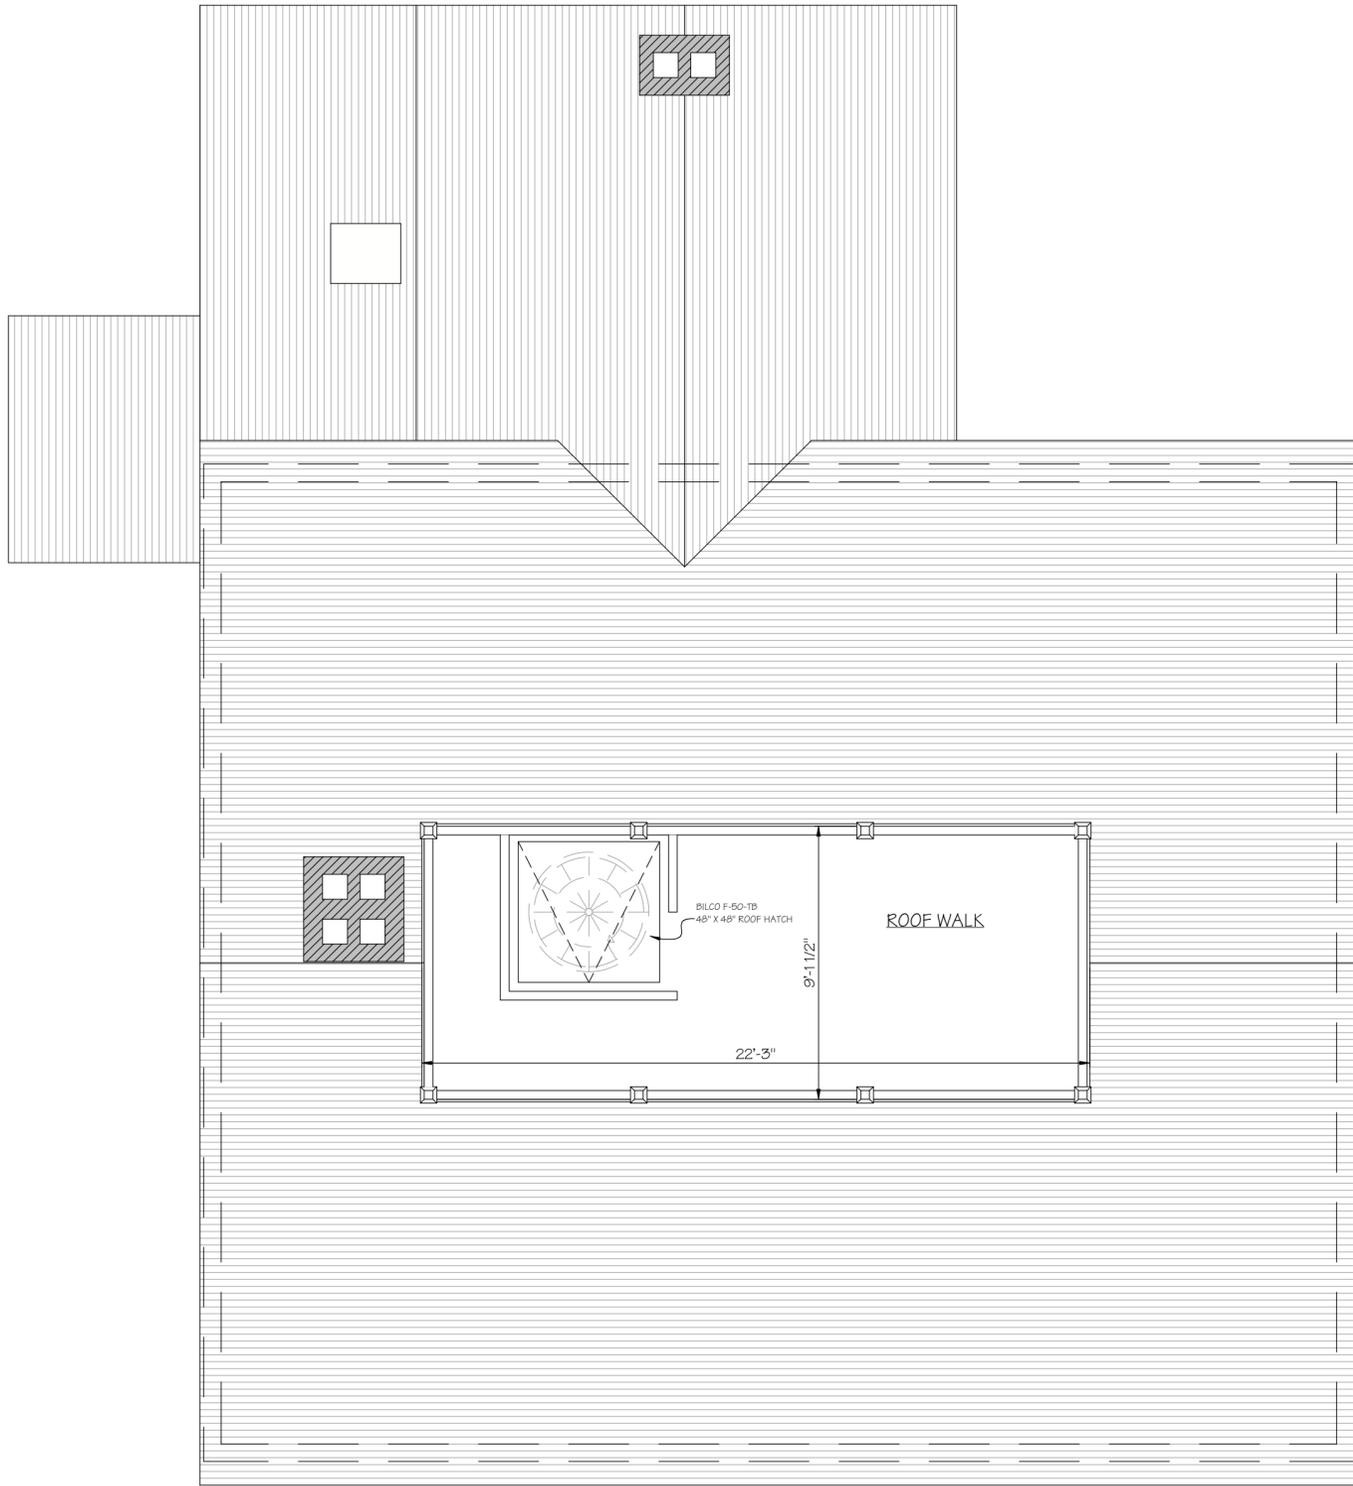


ROOF PLAN

NOT FOR CONSTRUCTION

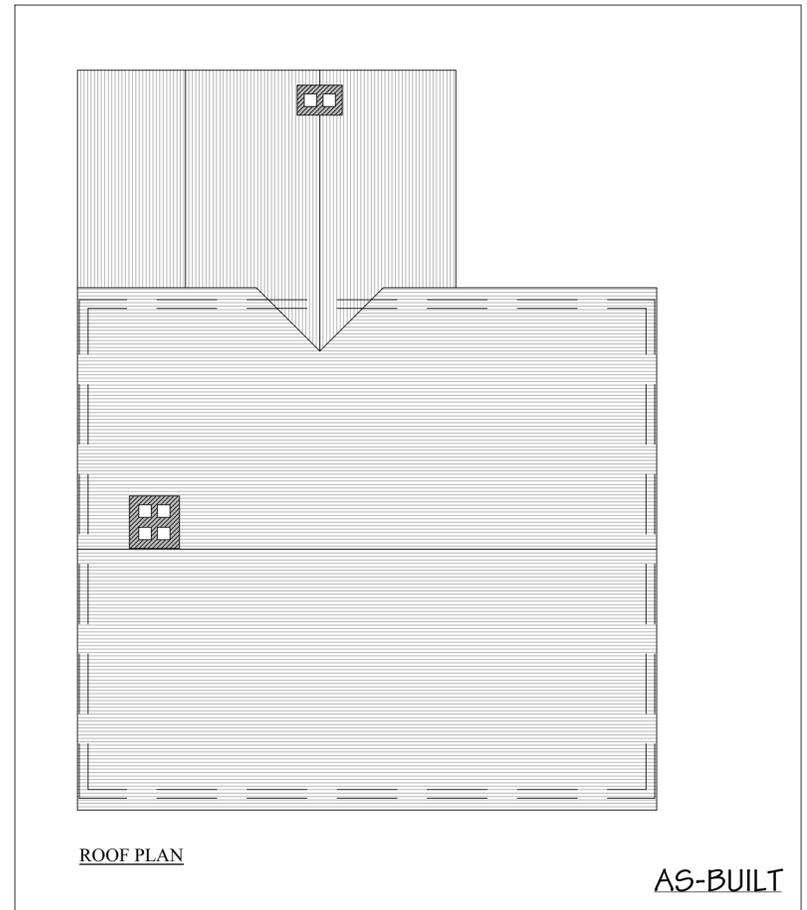


ROOF PLAN

AS-BUILT

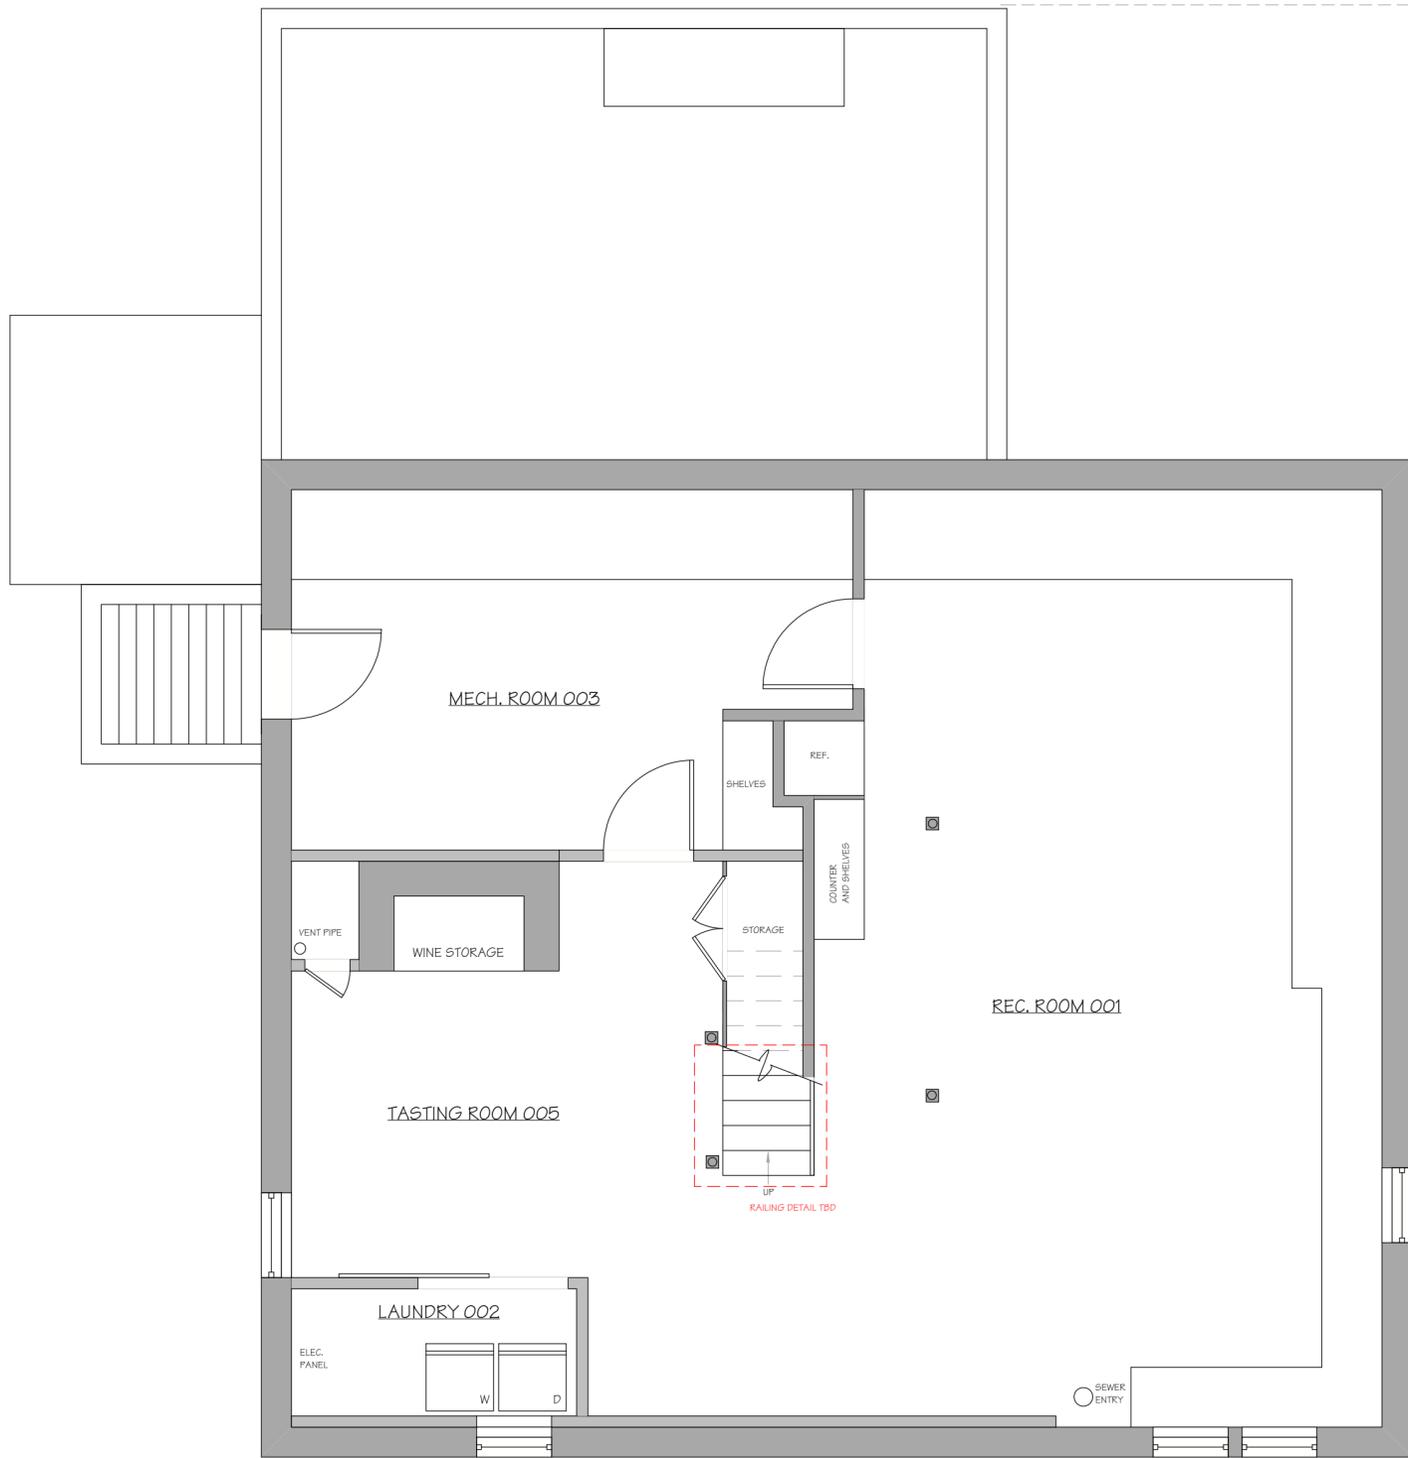

BASEMENT PLAN

NOT FOR CONSTRUCTION

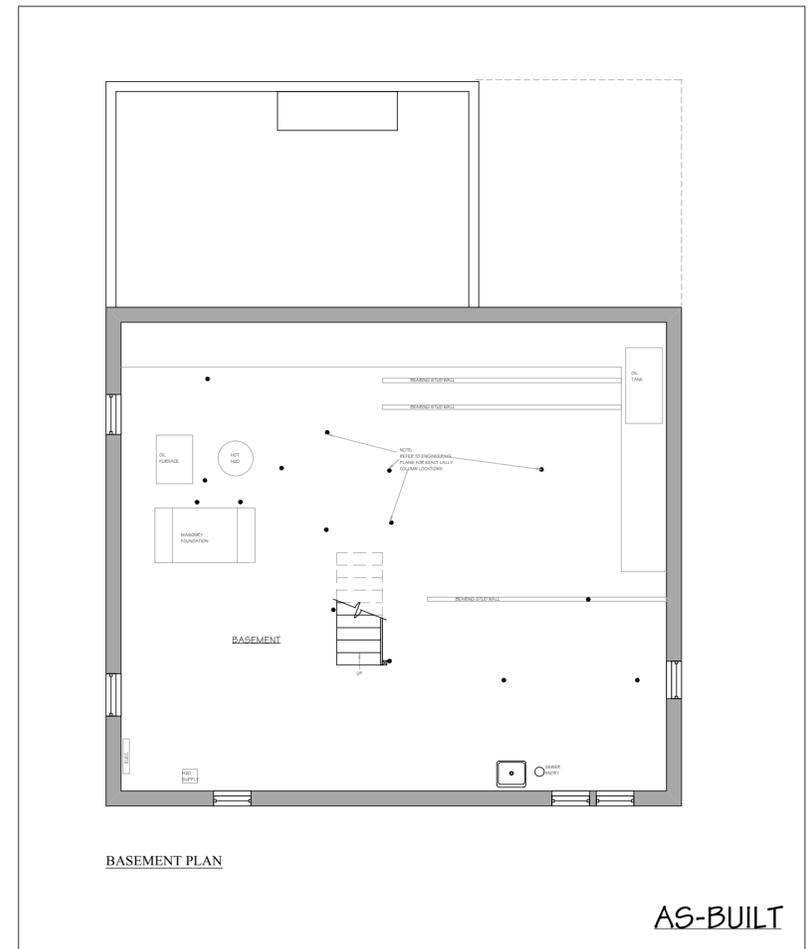


BASEMENT PLAN

AS-BUILT



SOUTH ELEVATION

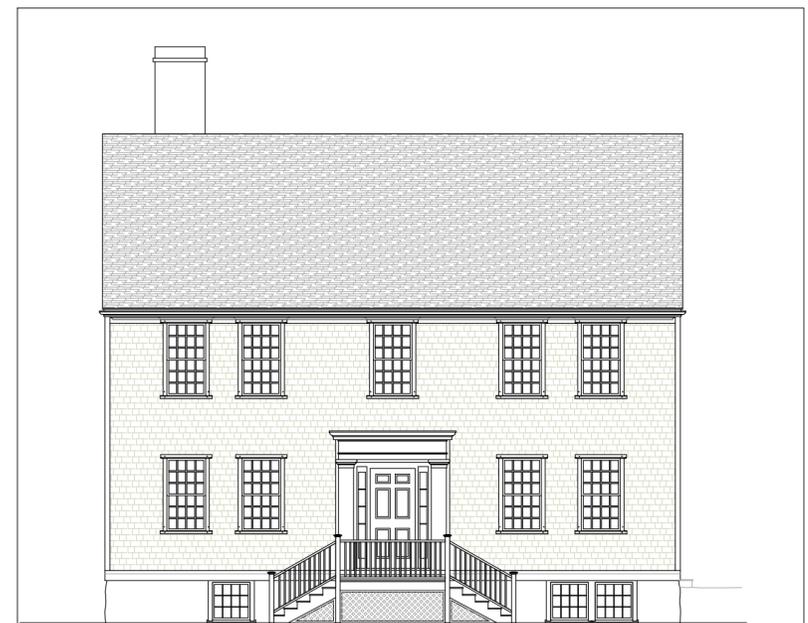

SOUTH ELEVATION

AS-BUILT

NOT FOR CONSTRUCTION


Design and drawings herein are property of Benjamin Normand Residential Design, Inc. and may be reproduced, stored in a retrieval system, or transmitted in any form or by any means, electronic, mechanical, photocopying, recording, or by any information storage and retrieval system, without the prior written permission of Benjamin Normand Residential Design, Inc. All rights reserved. Copyright laws are and will be enforced.

ELEVATION
 DATE: 04/11/2023
 SCALE: 1/4" = 1' 0"

M/P: 42.4.3 / 18

THE POGORELC RESIDENCE
 1 CHESTER ST
 NANTUCKET, MA

AS-BUILT

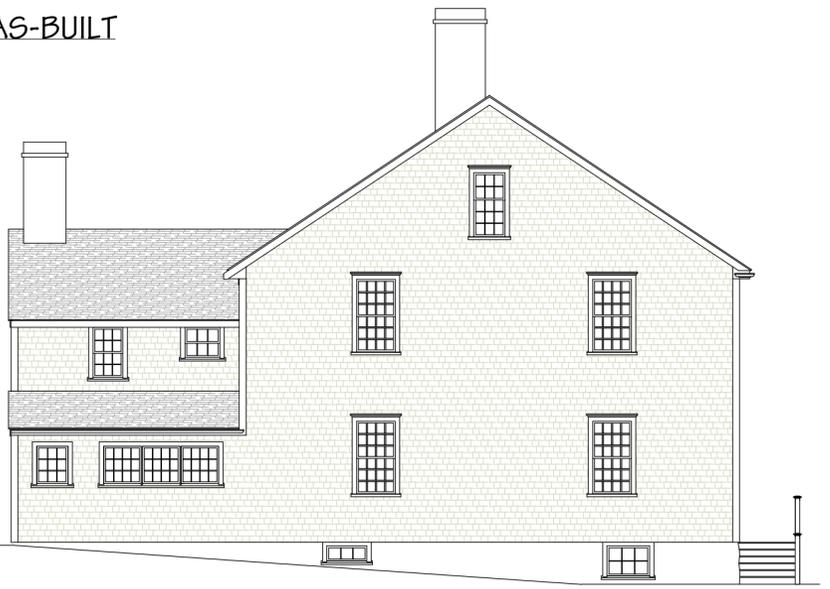

WEST ELEVATION



WEST ELEVATION

NOT FOR CONSTRUCTION

BENJAMIN
NORMAND RESIDENTIAL
DESIGN, INC
15 COMMERCIAL WHARF ~ NANTUCKET, MA 02554
(508) 228-2044 NORMANDRESIDENTIAL.COM

Design and drawings herein are property of Benjamin Normand Residential Design, Inc. and are not to be reproduced, stored in a retrieval system, or transmitted in any form or by any means, electronic, mechanical, photocopying, recording, or by any information storage and retrieval system, without the prior written permission of Benjamin Normand Residential Design, Inc. All applicable copyright laws can and will be enforced.

ELEVATION
DATE: 04/11/2023
SCALE: 1/4" = 1' 0"

M/P: 42.4.3 / 18

THE POGORELC RESIDENCE
1 CHESTER ST
NANTUCKET, MA



NORTH ELEVATION



NOT FOR CONSTRUCTION



NOT FOR CONSTRUCTION


BENJAMIN
NORMAND RESIDENTIAL
 DESIGN, INC
 15 COMMERCIAL WHARF ~ NANTUCKET, MA 02554
 (508) 228-2044 NORMANDRESIDENTIAL.COM

Design and drawings herein are property of Benjamin Normand Residential Design, Inc. and are not to be reproduced without the express authorization. All applicable copyright laws can and will be enforced.


ELEVATION
 DATE: 04/11/2023
 SCALE: 1/4" = 1' 0"

M/P: 42.4.3 / 1


THE POGORELC RESIDENCE
 1 CHESTER ST
 NANTUCKET, MA

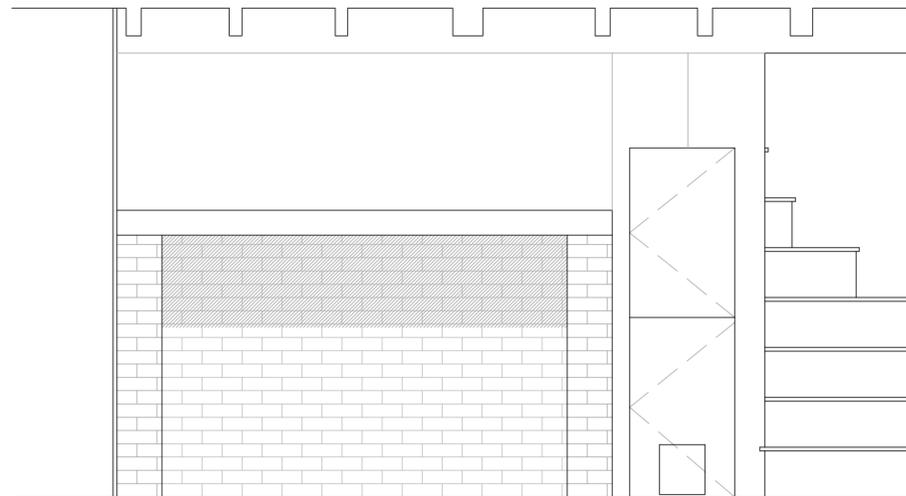



KITCHEN FIREPLACE - EXISTING CONDITIONS
SCALE: 1/2" = 1' 0"

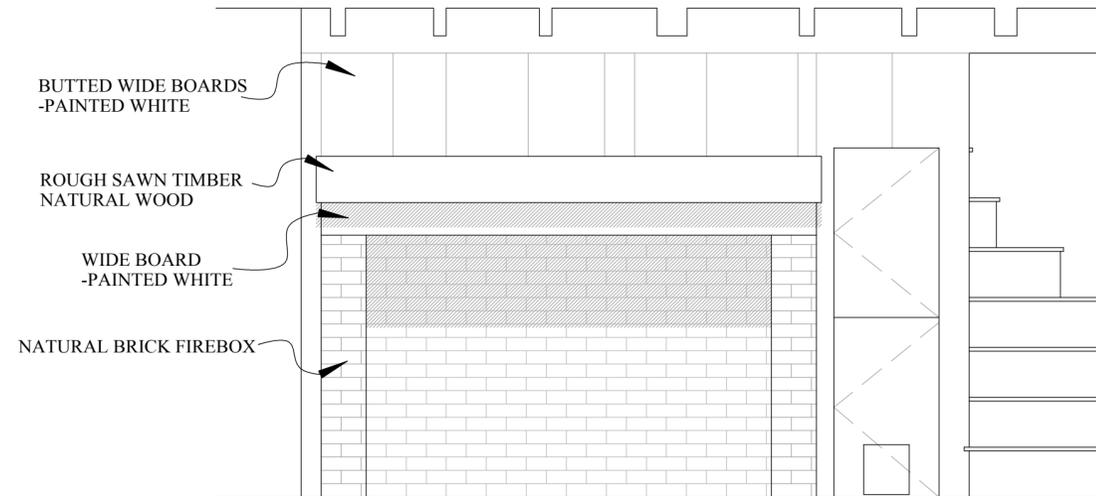


KITCHEN FIREPLACE - PROPOSED CONCEPT
SCALE: 1/2" = 1' 0"

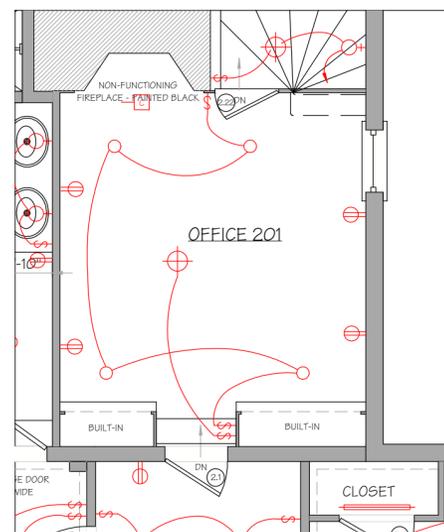


ELEVATION A
OFFICE 201 - BUILT-IN DETAIL
SCALE: 1/2" = 1' 0"

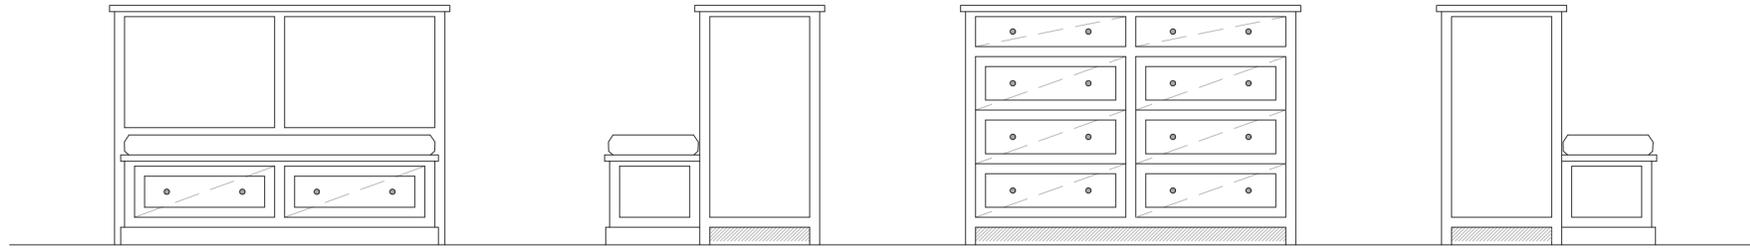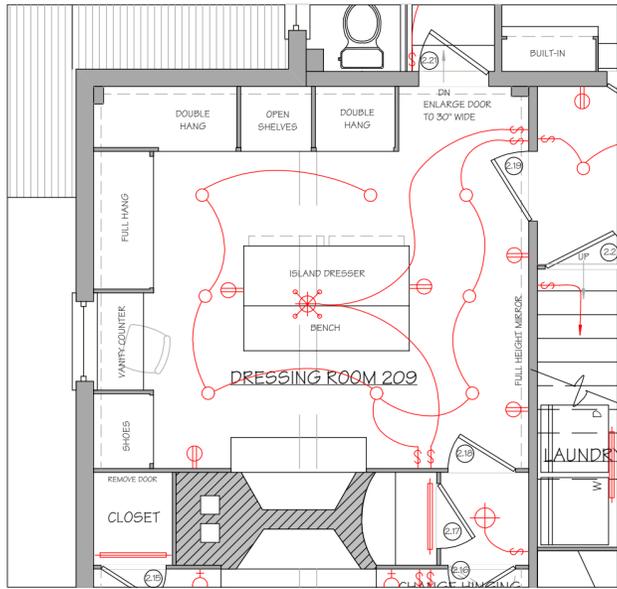


DRESSING ROOM - DRESSER/BENCH
SCALE: 1/2" = 1' 0"

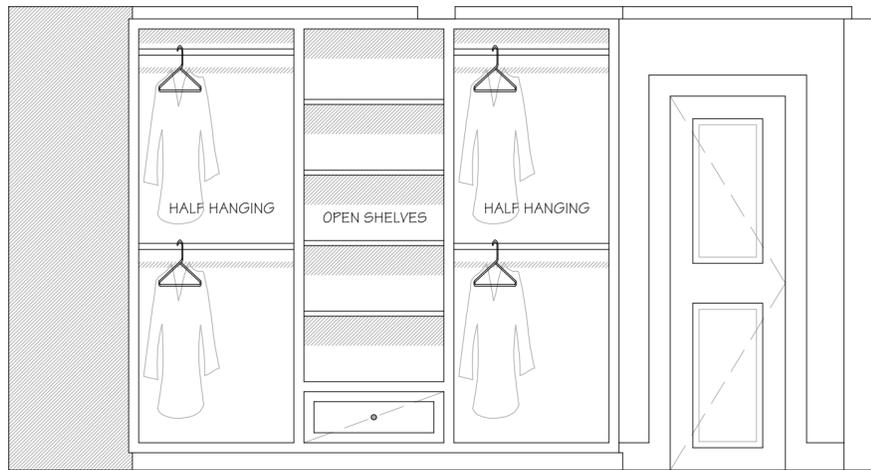


DRESSING ROOM - ELEVATION A
SCALE: 1/2" = 1' 0"

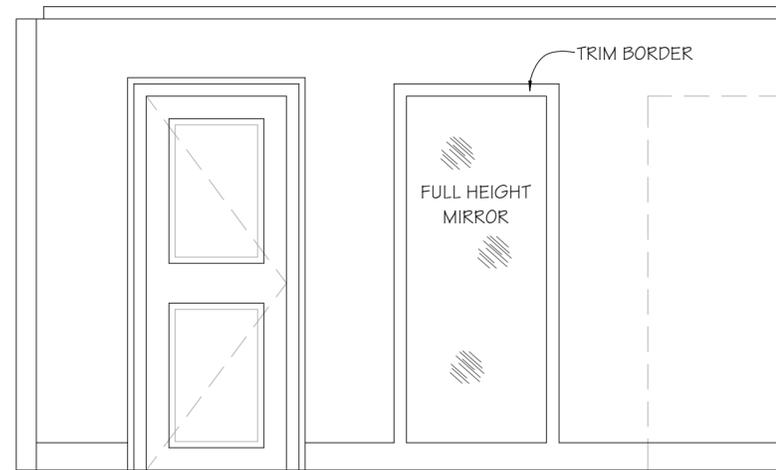

DRESSING ROOM - ELEVATION B
SCALE: 1/2" = 1' 0"

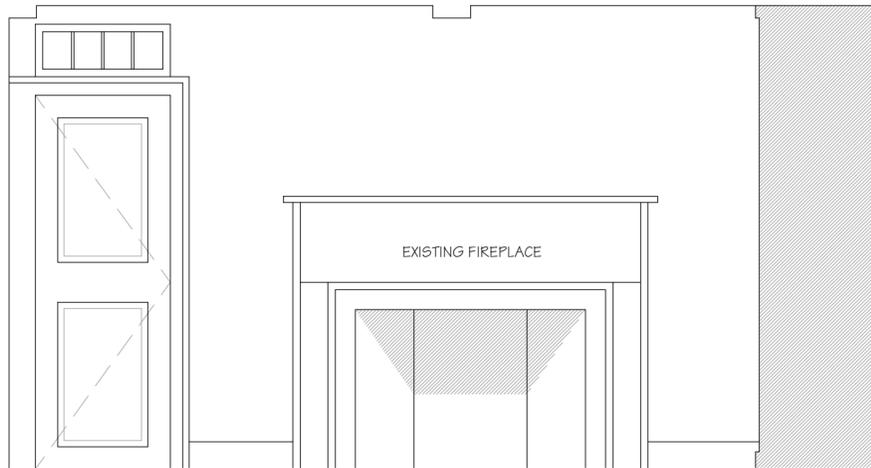


DRESSING ROOM - ELEVATION C
SCALE: 1/2" = 1' 0"

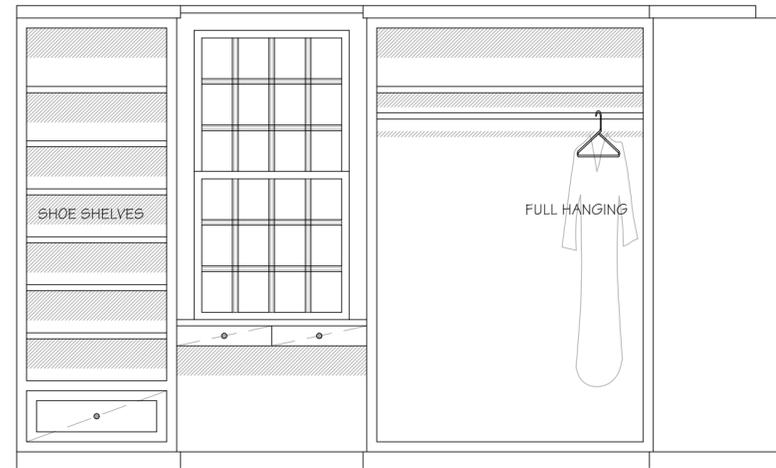



DRESSING ROOM - ELEVATION D
SCALE: 1/2" = 1' 0"



NOT FOR CONSTRUCTION

Design and drawings herein are property of Benjamin Normand Residential Design, Inc. All rights reserved. No part of this document may be reproduced, stored in a retrieval system, or transmitted in any form or by any means, electronic, mechanical, photocopying, recording, or by any information storage and retrieval system, without the prior written permission of Benjamin Normand Residential Design, Inc. All applicable copyright laws can and will be enforced.


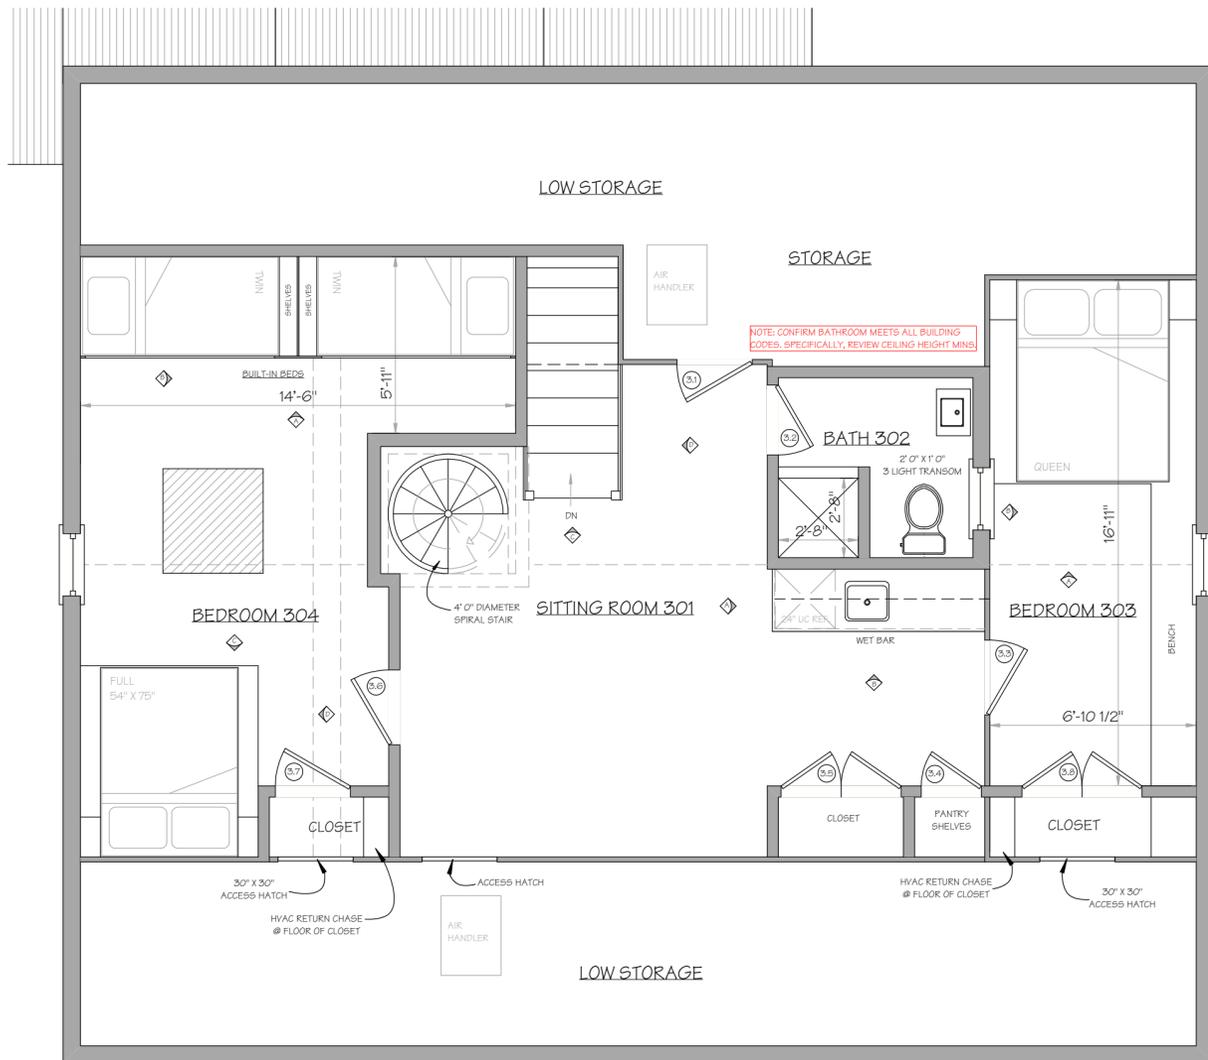


NOT FOR CONSTRUCTION

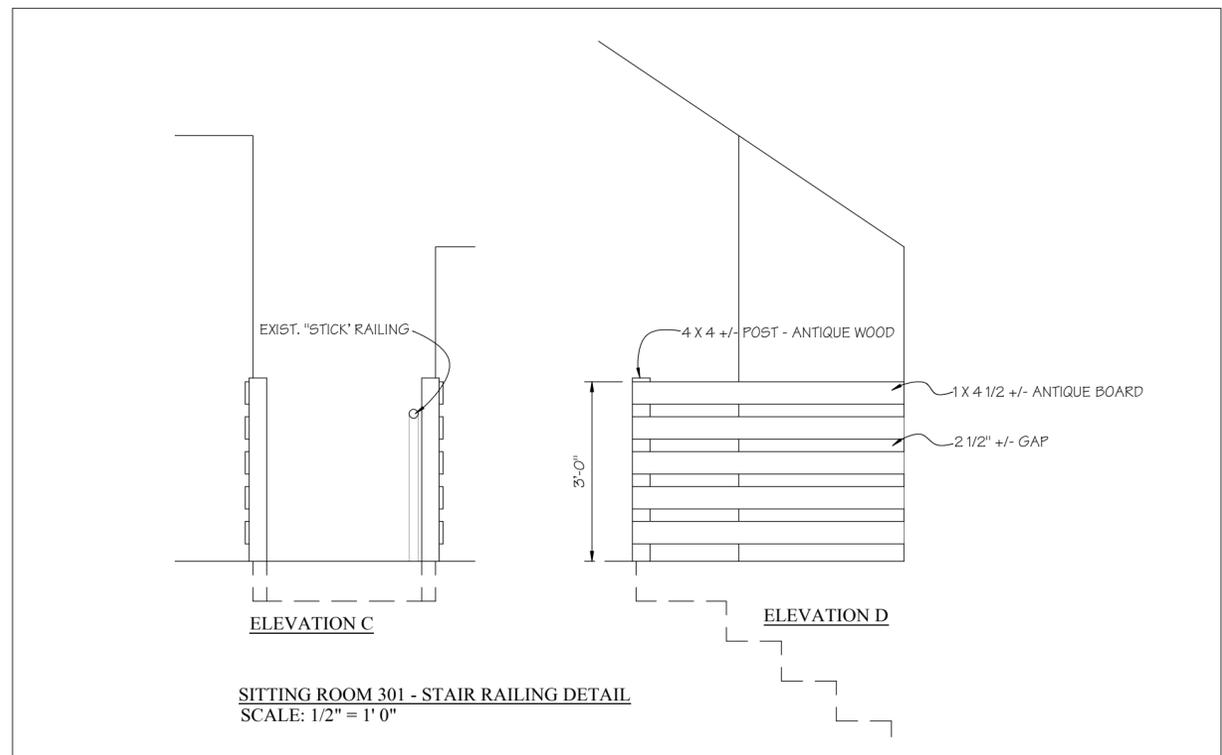
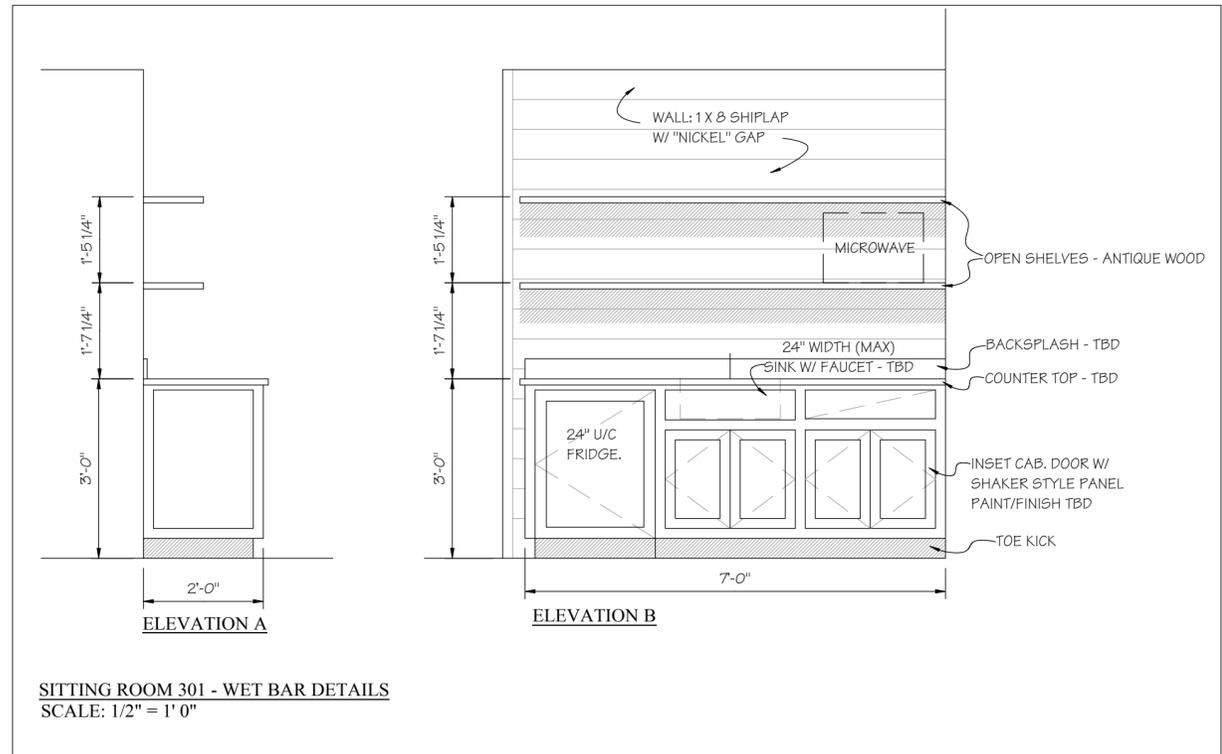


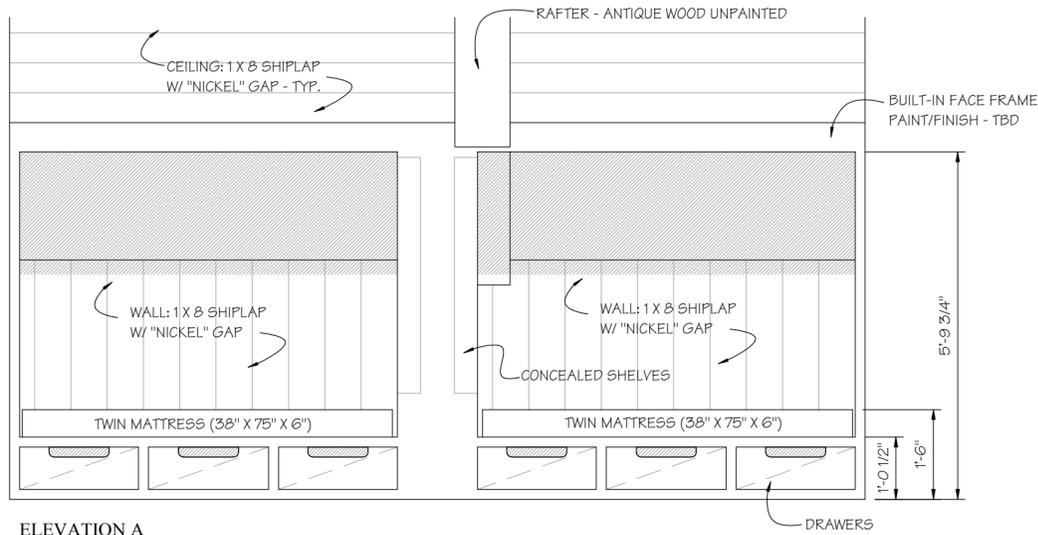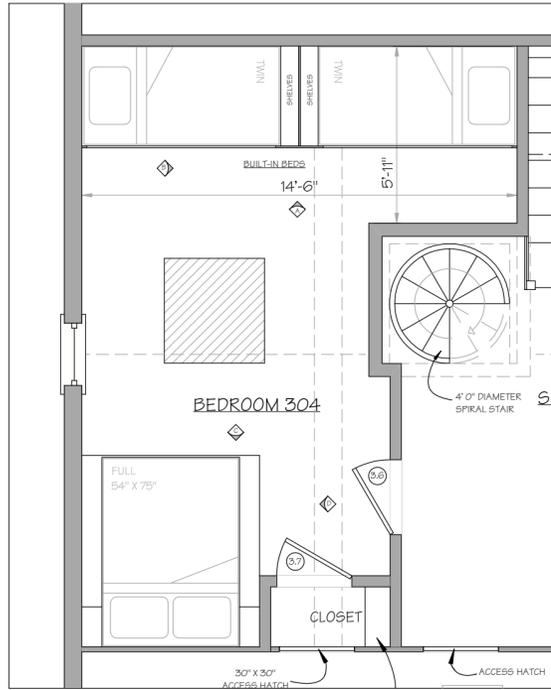


ELEVATION A
BEDROOM 304 - BUILT-IN BEDS DETAIL
 SCALE: 1/2" = 1' 0"

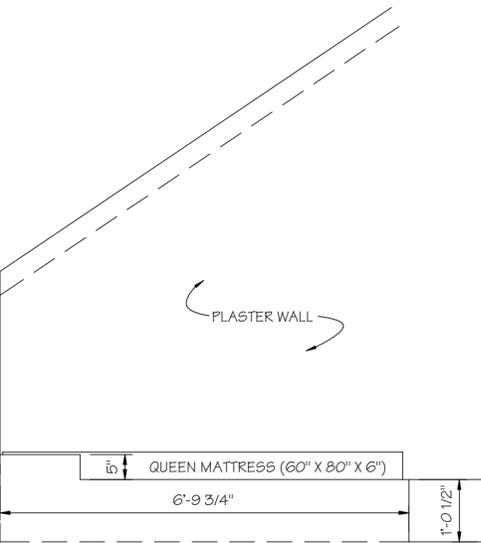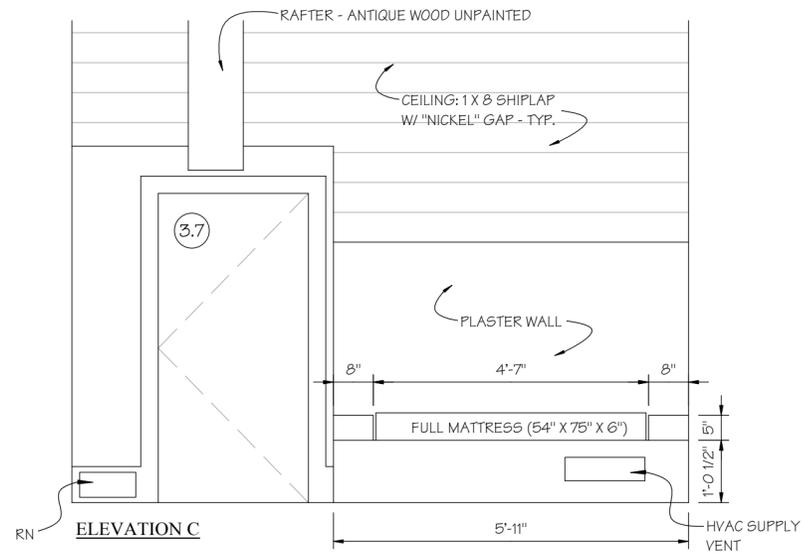

ELEVATION B
BEDROOM 303 - BUILT-IN BED DETAIL
 SCALE: 1/2" = 1' 0"

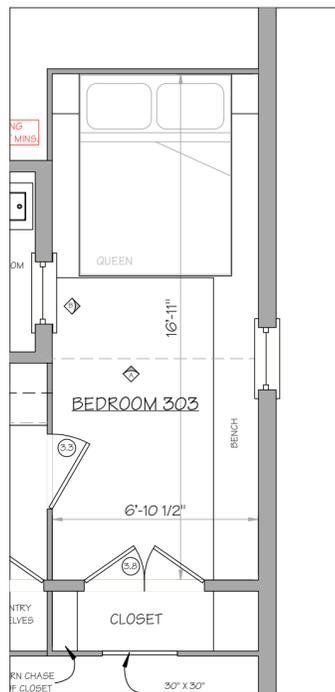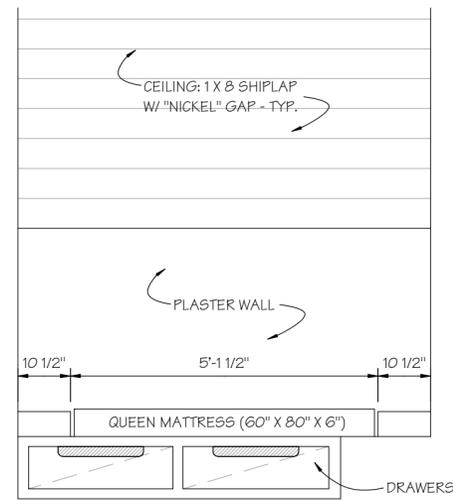

NOT FOR CONSTRUCTION

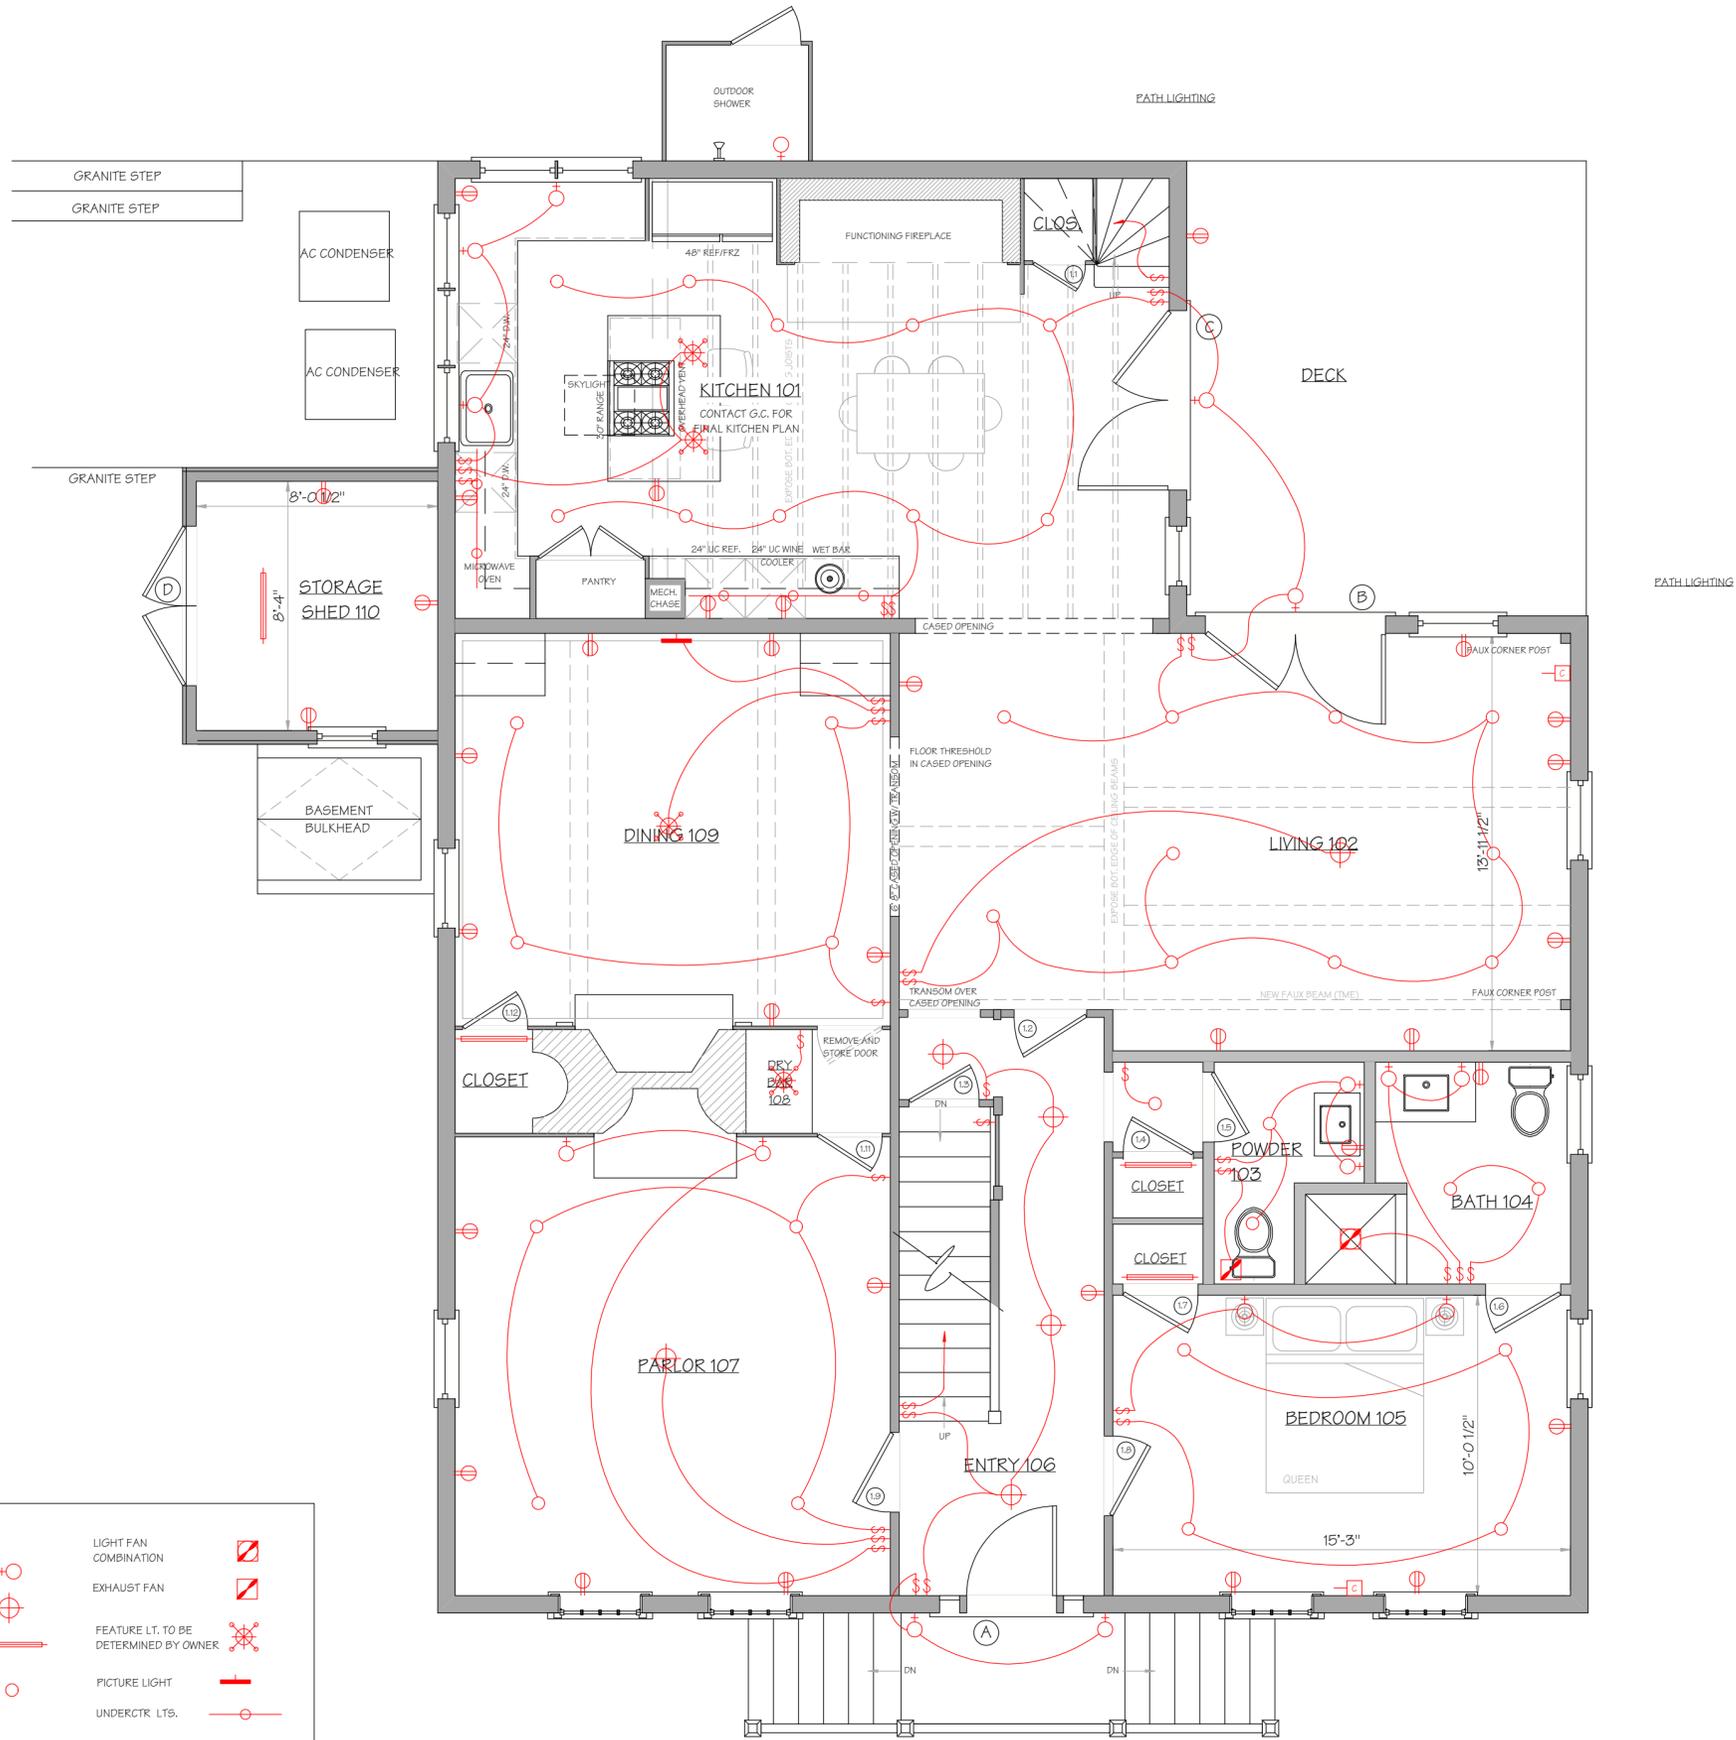

WALL SWITCH	Ⓢ	LIGHT FAN COMBINATION	Ⓢ
WALL MTD. LT. FIXTURE	⊕	EXHAUST FAN	Ⓢ
CLG. FIXT. SURFACE MOUNTED	⊕	FEATURE LT. TO BE DETERMINED BY OWNER	Ⓢ
CLOSET LIGHT ON MOTION SENSOR	Ⓢ	PICTURE LIGHT	Ⓢ
REC'D LIGHT	⊕	UNDERCTR. LTS.	Ⓢ
1/2 SWITCHED DUP.	Ⓢ	CABLE TV	Ⓢ
DUPLEX OUTLET	Ⓢ		

FIRST FLOOR PLAN

NOT FOR CONSTRUCTION

THE POGORELC RESIDENCE
1 CHESTER ST
NANTUCKET, MA


FIRST FLOOR ELECTRICAL PLAN
DATE: 04/11/2023
SCALE: 1/4" = 1'-0"

M/P: 42.4.3 / 18

Designed drawings are the property of Benjamin Normand Residential Design, Inc. and may not be used without their written consent. Copyright laws can and will be enforced.

BENJAMIN
NORMAND RESIDENTIAL
DESIGN, INC
15 COMMERCIAL WHARF - NANTUCKET, MA 02554
(508) 228-2044 - NORMANDRESIDENTIAL.COM

E1

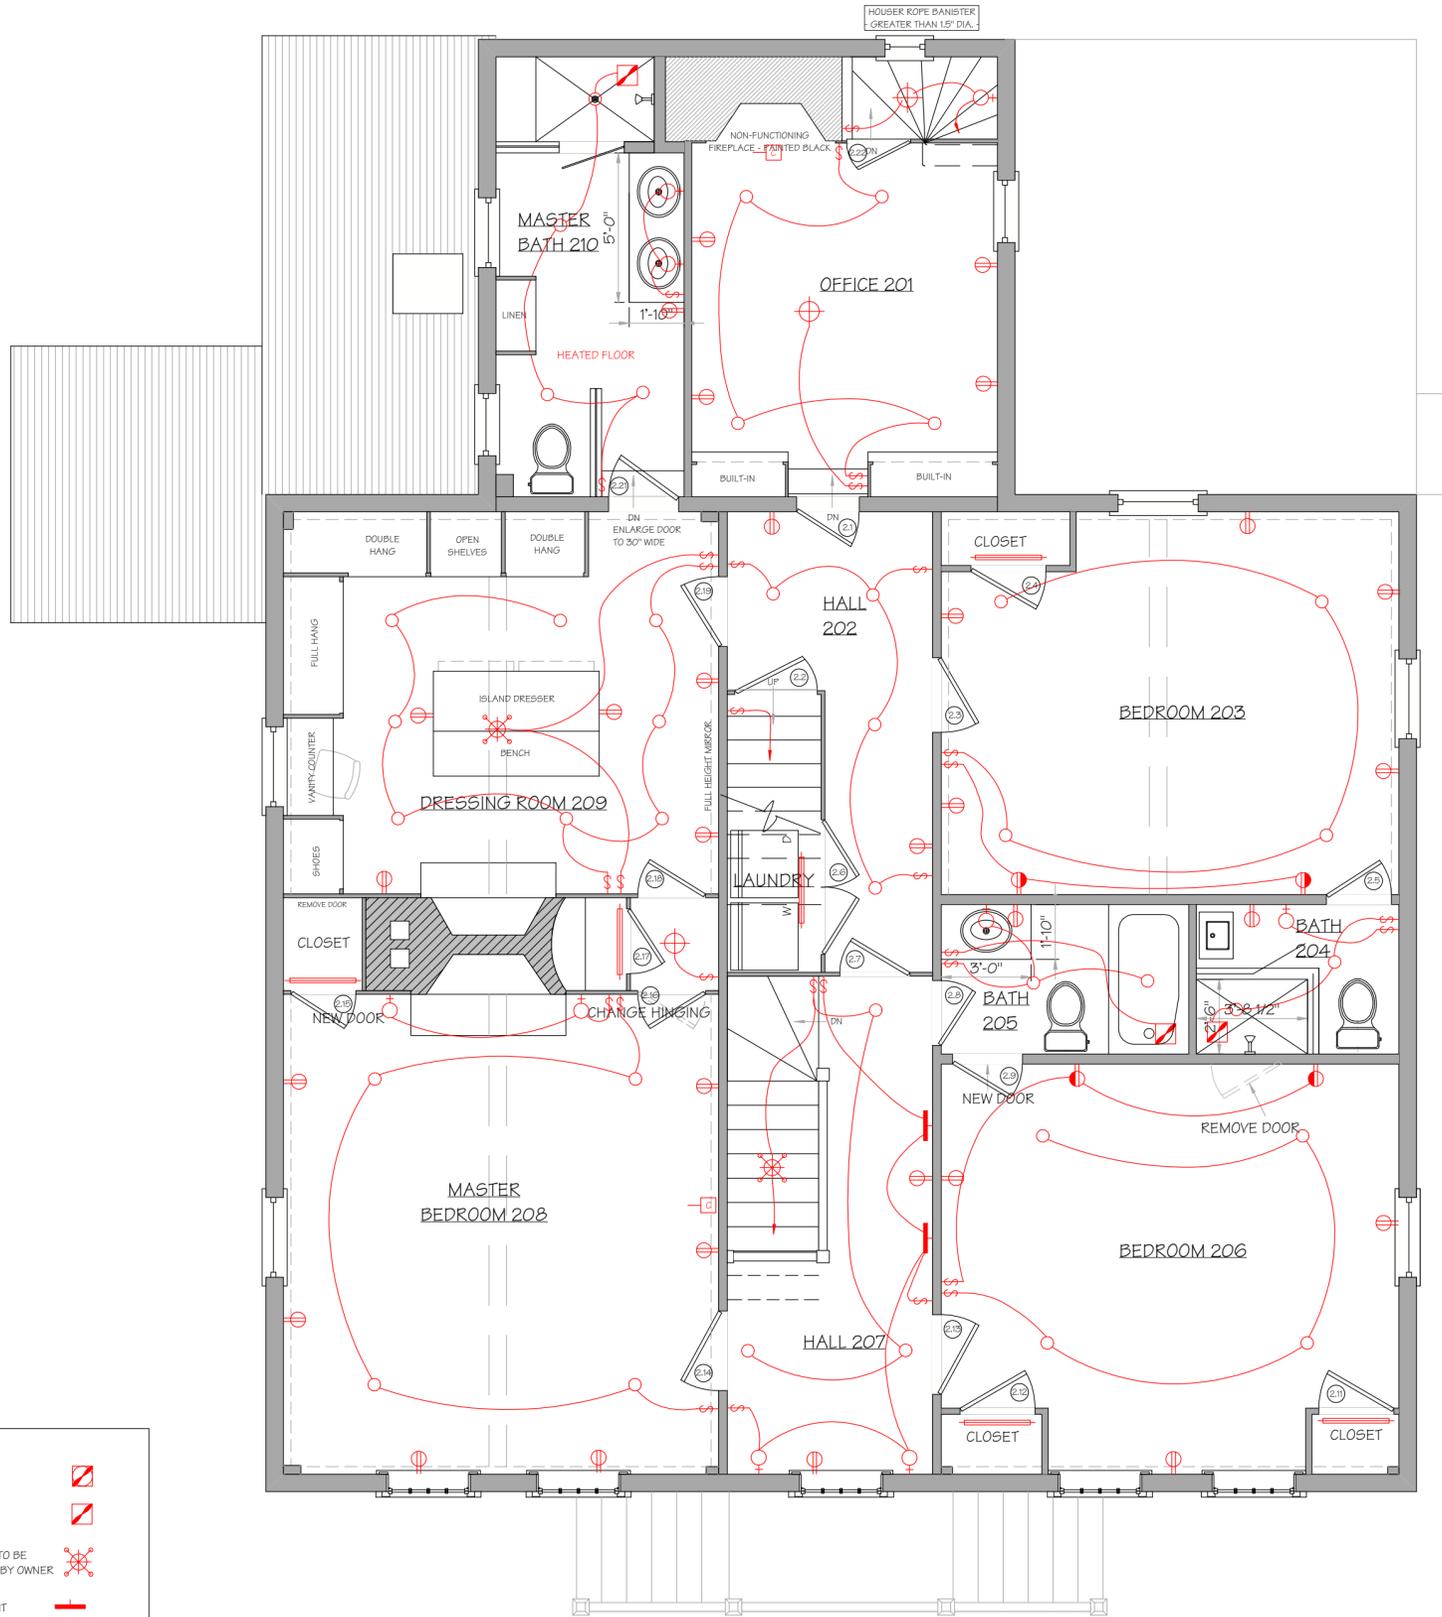


WALL SWITCH	⚡	LIGHT FAN COMBINATION	⚡/⊞
WALL MTD. LT. FIXTURE	⊞	EXHAUST FAN	⊞/⊞
CLG. FIXT. SURFACE MOUNTED	⊞	FEATURE LT. TO BE DETERMINED BY OWNER	⊞/⊞
CLOSET LIGHT ON MOTION SENSOR	⊞	PICTURE LIGHT	⊞
REC'D LIGHT	⊞	UNDERCTR. LTS.	⊞
1/2 SWITCHED DUP.	⊞	CABLE TV	⊞
DUPLEX OUTLET	⊞	PICTURE LIGHT	⊞

SECOND FLOOR PLAN

NOT FOR CONSTRUCTION

Design and drawings herein are property of Benjamin Normand Residential Design, Inc. Benjamin Normand Residential Design, Inc. expressly authorizes. All applicable copyright laws shall be enforced.

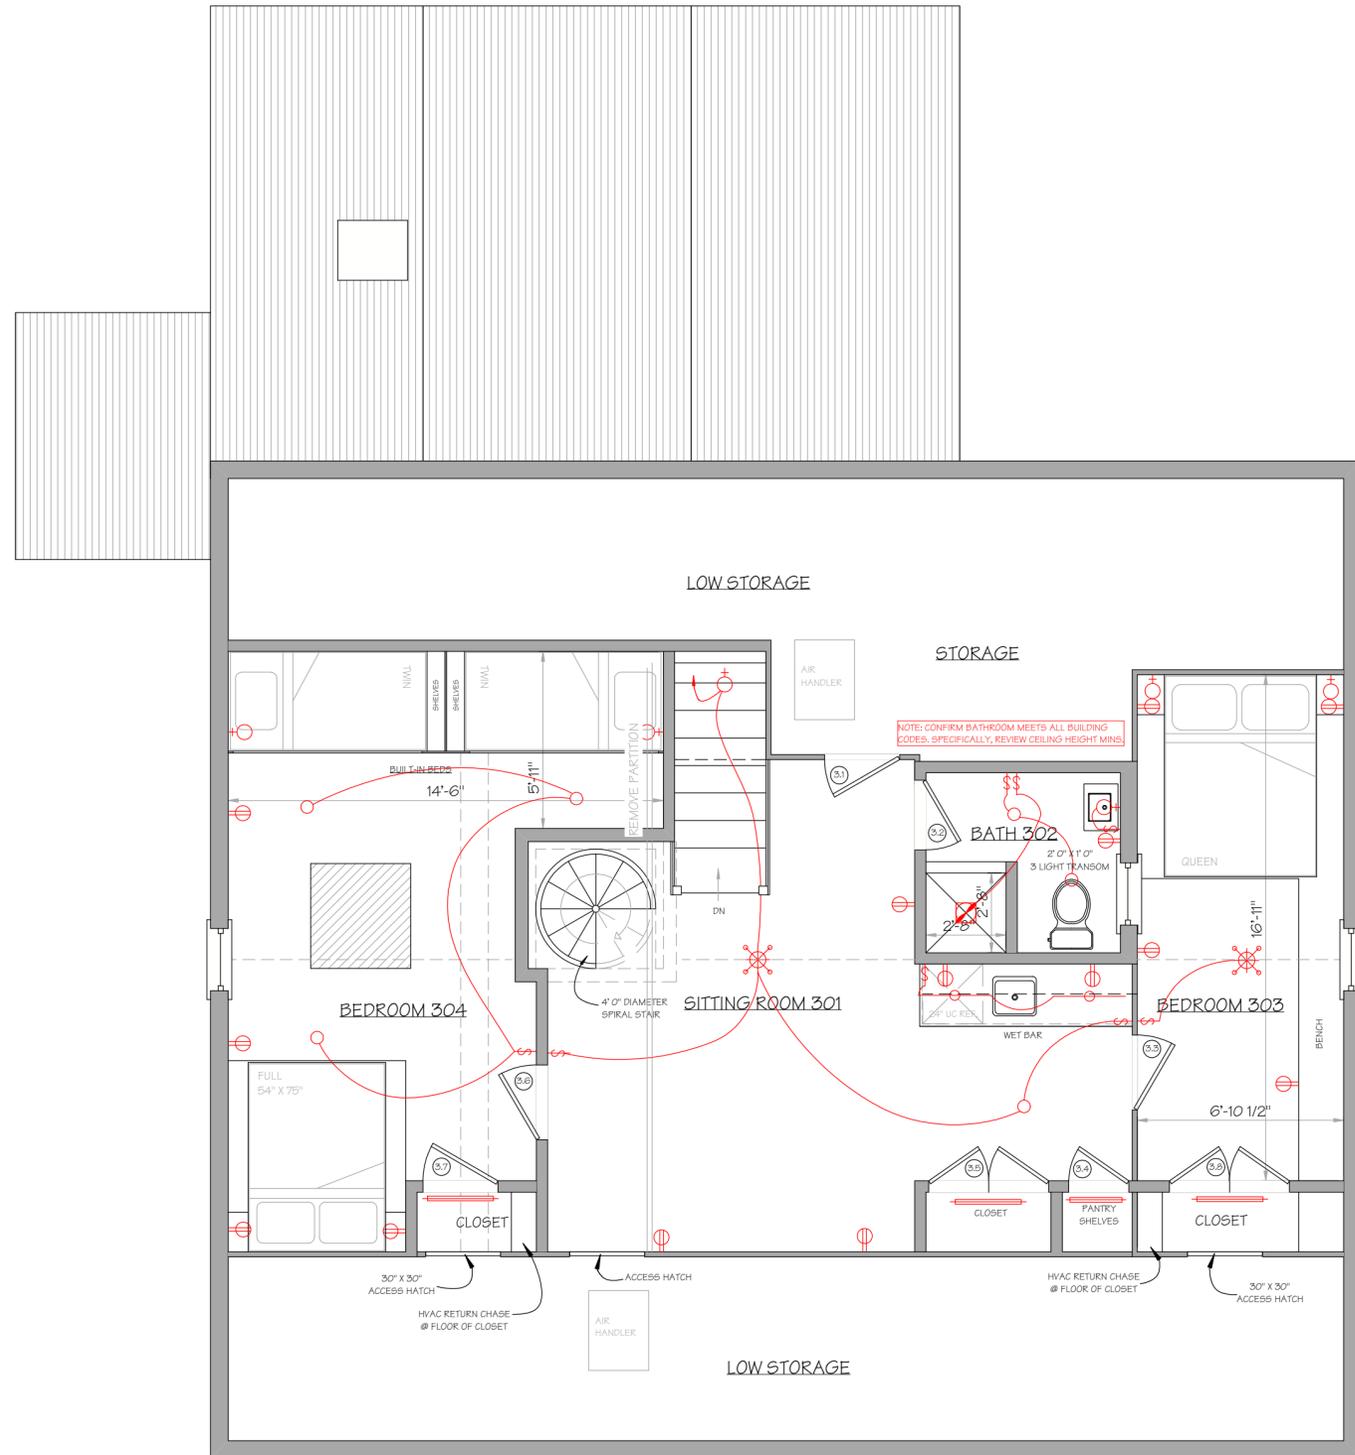

WALL SWITCH		LIGHT FAN COMBINATION	
WALL MTD. LT. FIXTURE		EXHAUST FAN	
CLG. FIXT. SURFACE MOUNTED		FEATURE LT. TO BE DETERMINED BY OWNER	
CLOSET LIGHT ON MOTION SENSOR		PICTURE LIGHT	
REC'D LIGHT		UNDERCTR. LTS.	
1/2 SWITCHED DUP.		CABLE TV	
DUPLEX OUTLET			

THIRD FLOOR PLAN

- GENERAL NOTES:
- THIRD FLOOR CATHEDRAL THROUGHOUT
 - ACCESS DOORS IN EACH BEDROOM INTO STORAGE SPACES
 - SHIPLAP WALLS TO BE PAINTED WHITE
 - CHIMNEY TO BE PARGED AND PAINTED WHITE